Document 2010 694

Book 2010 Page 694 Type 06 043 Pages 1
Date 3/31/2010 Time 3:05 PM
Rec Amt $9.00

INDX ✓
ANNO
SCAN

LISA SMITH, COUNTY RECORDER
MADISON COUNTY IOWA

CHEK

VANCE & HOCHSTETLER, P.C., CONSULTING ENGINEERS, WINTERSET, IOWA (515) 462-3995
CHARLES T. VANCE, 110 West Green St., Winterset, Iowa, 50273
JAMES M HOCHSTETLER, 110 West Green St., Winterset, Iowa 50273

09-130 S

UNITED STATES PUBLIC LAND SURVEY CORNER CERTIFICATE OF

Land Survey Monuments situated in Section 24, Township 77 N, Range 27 W, of the Fifth Principal Meridian, MADISON County, Iowa.


Previously recorded in _____ in County Recorder's Office.
(book, page, document number, etc.)


(Show reason for preparing this certificate, the evidence and detailed procedures used in establishing the the corner positions and monumentation found or placed.)


Monument Description and Remarks: NW COR SW¼ NE¼ - Found ½" I.R. Set by Schnoor and shown on plat of Parcel A" in 1993. NE COR SW¼ NE¼ - Set yellow CIR "6808 at midpoint on line between found NW Cor SW¼ NE¼ and found NE Cor SE¼ NE¼ and in line with fence South, SE COR SW¼ NE¼ - Set yellow CIR "6808 @ old property line fence Corner

PLAN - VIEW

(Show a minimum of three reference ties to durable physical objects, relevant monuments and physical conditions that will enable recovery of the corner.)

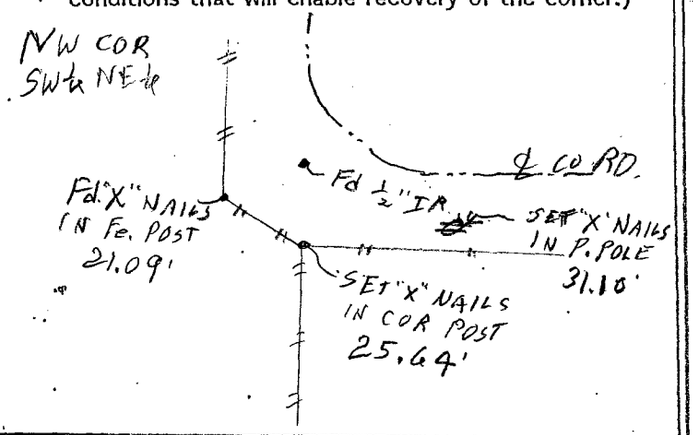

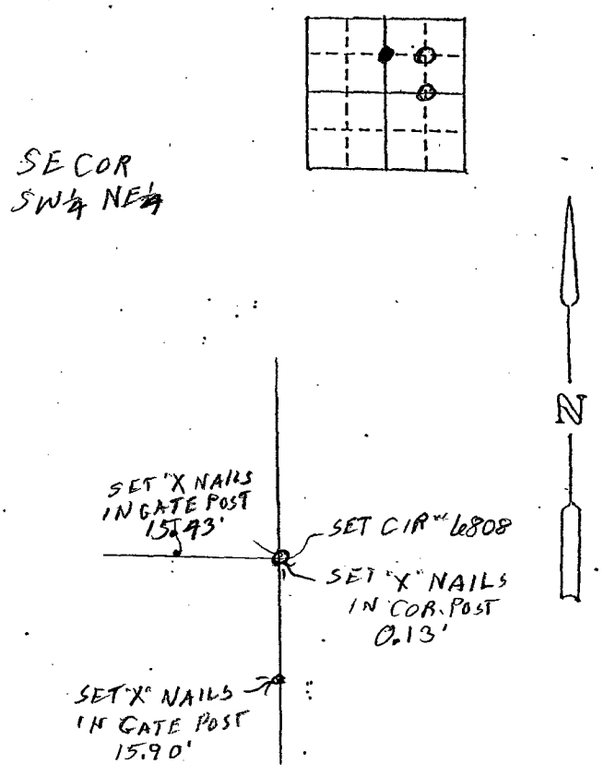

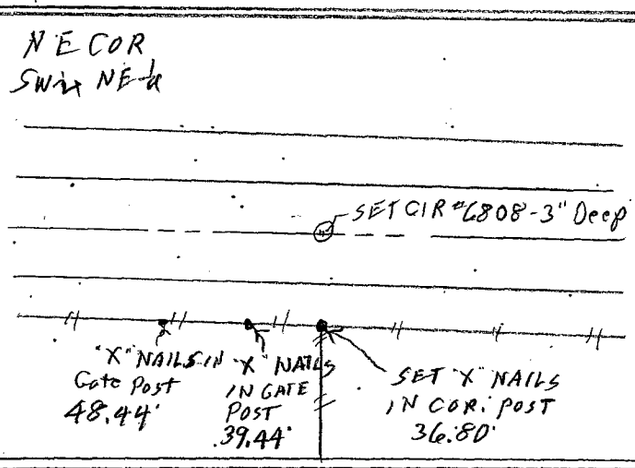

LICENSED LAND SURVEYOR
J. M. HOCHSTETLER
#6808
IOWA

I hereby certify that this land surveying document was prepared and the related survey work was performed by me or under my direct personal supervision and that I am a duly licensed Land Surveyor under the laws of the State of Iowa.

J.M. HOCHSTETLER
License number 6808 Date 3/20/10
My license renewal date is December 31, 2011
Pages or sheets covered by this seal: 1

List Corners to be Indexed

Corners	Section	Twp	Range
NW COR SW¼ NE¼	24	77	27
NE COR SW¼ NE¼	24	77	27
SE COR SW¼ NE¼	24	77	27