Document 2010 707

Book 2010 Page 707 Type 06 043 Pages 1
Date 4/01/2010 Time 12:38 PM
Rec Amt $9.00

INDX
ANNO
SCAN

LISA SMITH, COUNTY RECORDER
MADISON COUNTY IOWA

CHEK

Prepared By: J. Brian Morrissey, Morrissey Surveying, 1405 Hwy. G28, Otley, Ia. 50214, Tel. (641) 627-5554

UNITED STATES PUBLIC LAND SURVEY CORNER CERTIFICATE OF

Land Survey Monuments situated in Section 16, Township 76N, Range 27W, of the Fifth Principal Meridian, Madison County, Iowa.
Previously recorded in N.A. in County Recorders Office.


(book, page, document number, etc.)

(Show reason for preparing this certificate, the evidence and detailed procedures used in establishing the corner positions and monumentation found or placed.)


Monument Description and Remarks: Set 5/8" x 18" orange plastic capped rebar, #7995 at midpoint and on line between found N 1/4 corner and 3 way fence corner at NE corner of Section.

PLAN VIEW

(Show a minimum of three reference ties to durable physical objects, relevant monuments and physical conditions that will enable recovery of the corner.)

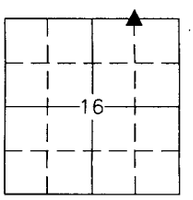


SET 5/8" x 18" ORANGE PLASTIC
CAPPED REBAR, #7995

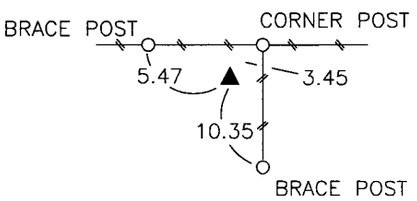



NE COR., NW 1/4 of the NE 1/4 SEC. 16

NOTE: ALL TIES TO "X" NAILS UNLESS NOTED.

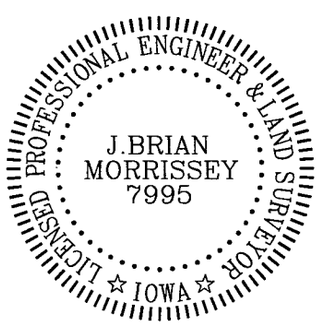

I hereby certify that this land surveying document was prepared and the related survey work was performed by me or under my direct personal supervision and that I am a duly Licensed Land Surveyor under the laws of the state of Iowa.

Signature: J. Brian Morrissey Date: 3/3/10
J. Brian Morrissey

License number 7995.
My license renewal date is December 31, 2011

612-09-1/1