Document 2010 1038

Book 2010 Page 1038 Type 06 043 Pages 1
Date 5/06/2010 Time 1:40 PM
Rec Amt $9.00

INDX
ANNO
SCAN

LISA SMITH, COUNTY RECORDER
MADISON COUNTY IOWA

CHEK

VANCE & HOCHSTETLER, P.C., CONSULTING ENGINEERS, WINTERSET, IOWA (515) 462-3995
CHARLES T. VANCE, 110 West Green St., Winterset, Iowa, 50273
JAMES M HOCHSTETLER, 110 West Green St., Winterset, Iowa 50273

10-34S

UNITED STATES PUBLIC LAND SURVEY CORNER CERTIFICATE OF

Land Survey Monuments situated in Section 1, Township 74 N, Range 26 W, of the Fifth Principal Meridian, MADISON County, Iowa.
Previously recorded in _____ In County Recorder's Office.
(book, page, document number, etc.)


(Show reason for preparing this certificate, the evidence and detailed procedures used in establishing the the corner positions and monumentation found or placed.)


Monument Description and Remarks: N.W. COR NEFr¼ NE¼ - Set yellow CIR #6808 at midpoint on line between found NE Cor and N¼ Cor.

SW Cor NEFr¼ NE¼ - Set yellow CIR #6808 on line between found SE COR NEFr¼ NE¼ and found SW Cor E½ NWFr¼ NE¼. SE Cor NWFr¼ NE¼ is at midpoint on line between found SE Cor NEFr¼ NE¼ & calculated SW Cor. NWFr¼ NE¼.

PLAN - VIEW

(Show a minimum of three reference ties to durable physical objects, relevant monuments and physical conditions that will enable recovery of the corner.)

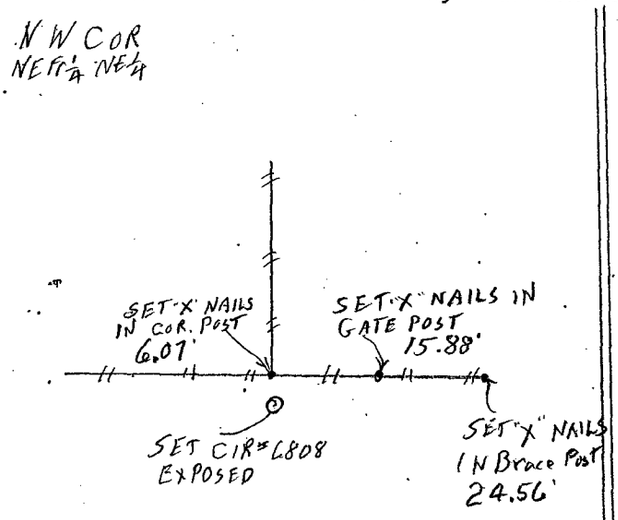

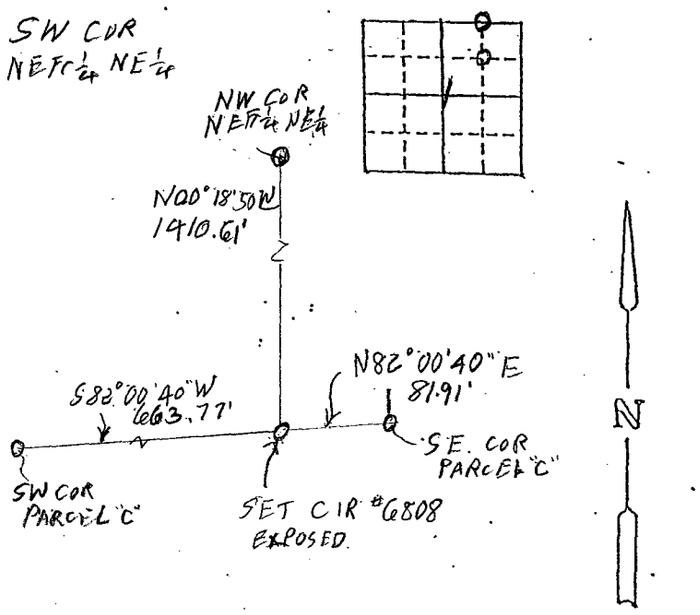

LICENSED LAND SURVEYOR
J. M.
HOCHSTETLER
#6808
IOWA

I hereby certify that this land surveying document was prepared and the related survey work was performed by me or under my direct personal supervision and that I am a duly licensed Land Surveyor under the laws of the State of Iowa.

J.M. HOCHSTETLER
License number 6808 Date 5/3/10
My license renewal date is December 31, 2011
Pages or sheets covered by this seal: 1

List Corners to be Indexed

Corners	Section	Twp	Range
NW COR NEFr¼ NE¼	1	74N	26W
SW COR NEFr¼ NE¼	1	74N	26W