Document 2010 1318

Book 2010 Page 1318 Type 06 043 Pages 1
Date 6/10/2010 Time 3:57 PM
Rec Amt $9.00

INDX
ANNO
SCAN

LISA SMITH, COUNTY RECORDER
MADISON COUNTY IOWA

CHEK

VANCE & HOCHSTETLER, P.C., CONSULTING ENGINEERS, WINTERSET, IOWA (515) 462-3995
CHARLES T. VANCE, 110 West Green St., Winterset, Iowa, 50273
JAMES M HOCHSTETLER, 110 West Green St., Winterset, Iowa 50273

10-505

UNITED STATES PUBLIC LAND SURVEY CORNER CERTIFICATE OF

Land Survey Monuments situated in Section 25, Township 75 N, Range 26 W, of the Fifth Principal Meridian, MADISON County, Iowa.
Previously recorded in _____ in County Recorder's Office.
(book, page, document number, etc.)


(Show reason for preparing this certificate, the evidence and detailed procedures used in establishing the the corner positions and monumentation found or placed.)


Monument Description and Remarks: SE COR SW¼SW¼ - Found CIR # 6808 Set for a survey a number of years ago in Section 36-75-26


PLAN - VIEW

(Show a minimum of three reference ties to durable physical objects, relevant monuments and physical conditions that will enable recovery of the corner.)

SE. COR
SW¼SW¼
SEC. 25-75-26

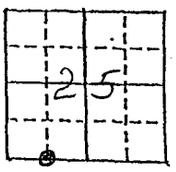

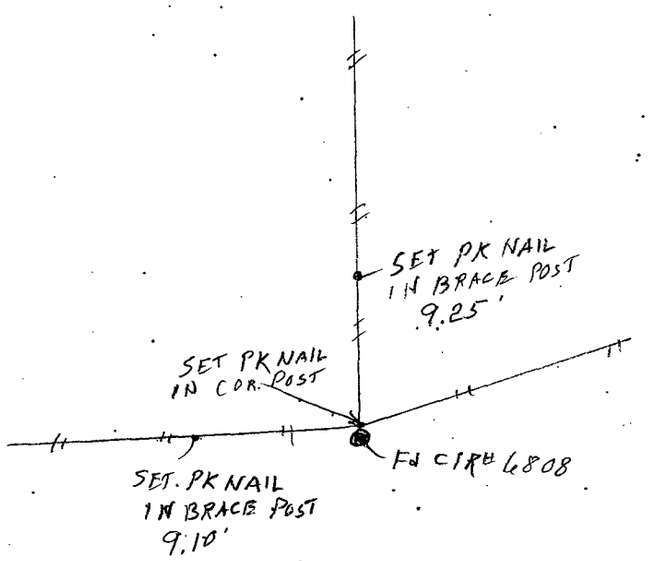

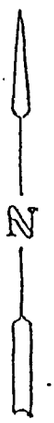

LICENSED LAND SURVEYOR
J. M.
HOCHSTETLER
#6808
IOWA

I hereby certify that this land surveying document was prepared and the related survey work was performed by me or under my direct personal supervision and that I am a duly licensed Land Surveyor under the laws of the State of Iowa.

J.M. Hochstetler
J.M. HOCHSTETLER
License number 6808 Date 5/28/10
My license renewal date is December 31, 2011.
Pages or sheets covered by this seal: 1

List Corners to be Indexed

Corners	Section	Twp.	Range
SE COR SW¼ SW¼	25	75N	26W