

Posts 0018 P 4054 T 00


Book 2010 Page 1354 Type 06 026 Pages 1 Date 6/14/2010 Time 4:09 PM Rec Amt \$7.00

LISA SMITH, COUNTY RECORDER MADISON COUNTY IOWA

INDX / ANNO SCAN CHEK

VANCE & HOCHSTETLER, P.C. • CONSULTING ENGINEERS • WINTERSET. IOWA • 50273

CHARLES T. VANCE • 110 WEST GREEN ST., WINTERSET, IOWA • (515) 462-3995
JAMES M HOCHSTETLER • 110 WEST GREEN ST., WINTERSET, IOWA • FAX: (515) 462 9845

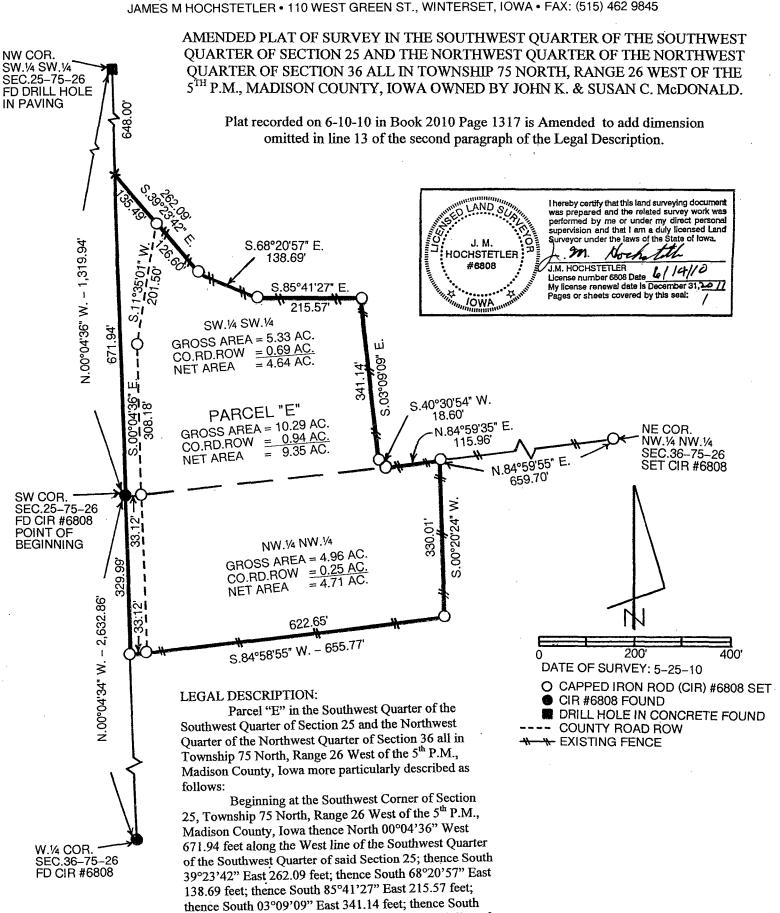

40°30'54" West 18.60 feet to a point on the North line of the Northwest Quarter of the Northwest Quarter of Section 36, Township 75 North, Range 26 West of the 5th P.M., Madison County, Iowa; thence North 84°59'35" East 115.96 feet along the North line of said Northwest Quarter of the Northwest Quarter; thence South 00°20'24" West 330.01 feet; thence South 84°58'55" West 655.77 feet to the West line of said Northwest Quarter of the Northwest Quarter; thence North 00°04'34" West 329.99 feet to the Point of Beginning containing 10.29 acres including 0.94 acres of County

Road right-of-way.