Document 2010 1543

Book 2010 Page 1543 Type 06 043 Pages 1
Date 7/07/2010 Time 2:28 PM
Rec Amt $9.00

INDX
ANNO
SCAN

LISA SMITH, COUNTY RECORDER
MADISON COUNTY IOWA

CHEK

VANCE & HOCHSTETLER, P.C., CONSULTING ENGINEERS, WINTERSET, IOWA (515) 462-3995
CHARLES T. VANCE, 110 West Green St., Winterset, Iowa, 50273
JAMES M HOCHSTETLER, 110 West Green St., Winterset, Iowa 50273

10-555

UNITED STATES PUBLIC LAND SURVEY CORNER CERTIFICATE


OF


Land Survey Monuments situated in Section 25, Township 76 N, Range 29 W, of the Fifth Principal Meridian, MADISON County, Iowa.
Previously recorded in _____ in County Recorder's Office.
(book, page, document number, etc.)


(Show reason for preparing this certificate, the evidence and detailed procedures used in establishing the the corner positions and monumentation found or placed.)
Monument Description and Remarks: S¼ Cor - Set yellow CIR #6808 at ℄ County Road in line with established property line to North, NE Cor. SE¼ SE¼ - Set PK Nail on line between SE. COR & E¼ Cor. at point 0.03' South of mid point. Matches property line fence & previous survey. NW Cor SE¼ SE¼ - Set yellow CIR #6808 at old property line fence Corner

PLAN - VIEW

(Show a minimum of three reference ties to durable physical objects, relevant monuments and physical conditions that will enable recovery of the corner.)

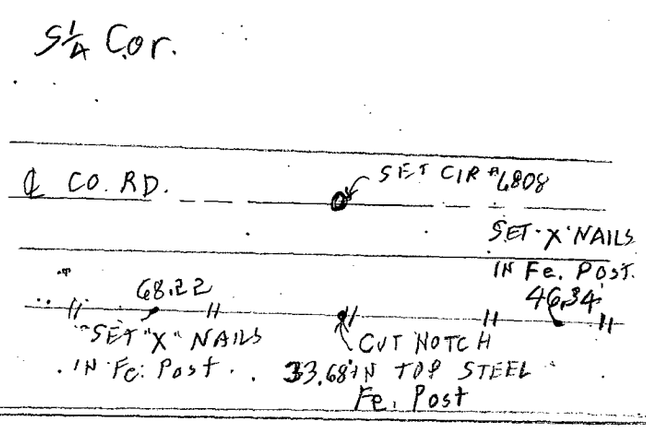

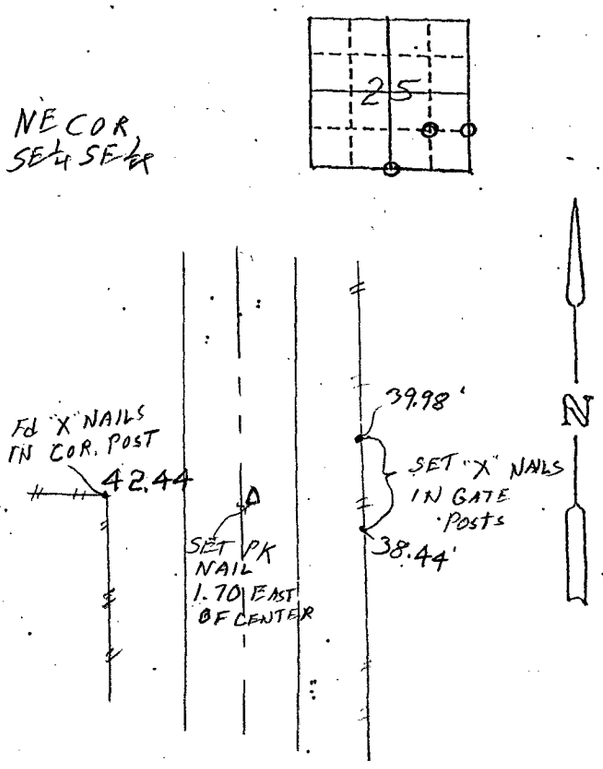

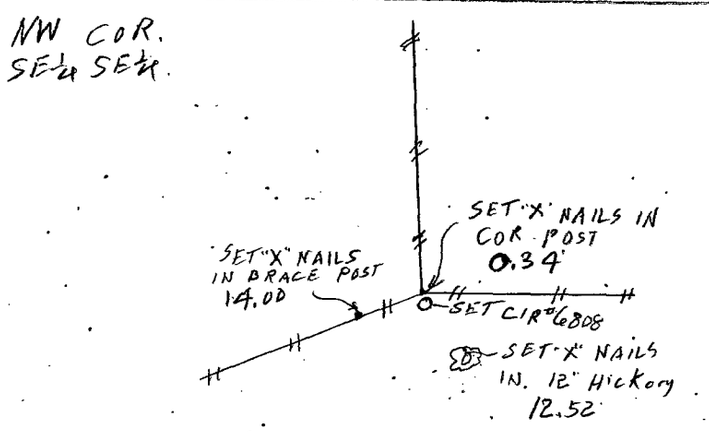

LICENSED LAND SURVEYOR
J. M. HOCHSTETLER
#6808
IOWA

I hereby certify that this land surveying document was prepared and the related survey work was performed by me or under my direct personal supervision and that I am a duly licensed Land Surveyor under the laws of the State of Iowa.

J.M. Hochstetler
J.M. HOCHSTETLER
License number 6808 Date 6/17/10
My license renewal date is December 31, 2011
Pages or sheets covered by this seal:

List Corners to be Indexed

Corners	Section	Twp	Range
S¼ Cor	25	76N	29W
NE COR SE¼ SE¼	25	76N	29W
NW COR SE¼ SE¼	25	76N	29W