Document 2010 1567

Book 2010 Page 1567 Type 06 043 Pages 1
Date 7/08/2010 Time 2:09 PM
Rec Amt $9.00

INDX ✓
ANNO
SCAN

LISA SMITH, COUNTY RECORDER
MADISON COUNTY IOWA

CHEK

HACKETT SURVEYING, Prepared By: Michael James Hackett, 712 North 9th Avenue, Winterset, Ia. 50273, Tel. (515) 462-1106

UNITED STATES PUBLIC LAND SURVEY CORNER CERTIFICATE OF


Land Survey Monuments situated in Section 15, Township 75 N, Range 29 W, of the Fifth Principal Meridian, Madison County, Iowa.
Previously recorded in BOOK 1, PAGE 52 in County Recorder's Office.
(book, page, document number, etc.)


(*Show reason for preparing this certificate, the evidence and detailed procedures used in establishing the corner positions and* monumentation found or placed.)

Monument Description and Remarks: Found iron pin with yellow plastic cap, #6808. The reason for preparing this certificate is that the ties to the corner have changed. Confirmed corner location by traversing the south half of section.

PLAN VIEW

(Show a minimum of three reference ties to durable physical objects, relevant monuments and physical conditions that will enable recovery of the corner.)

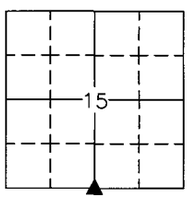

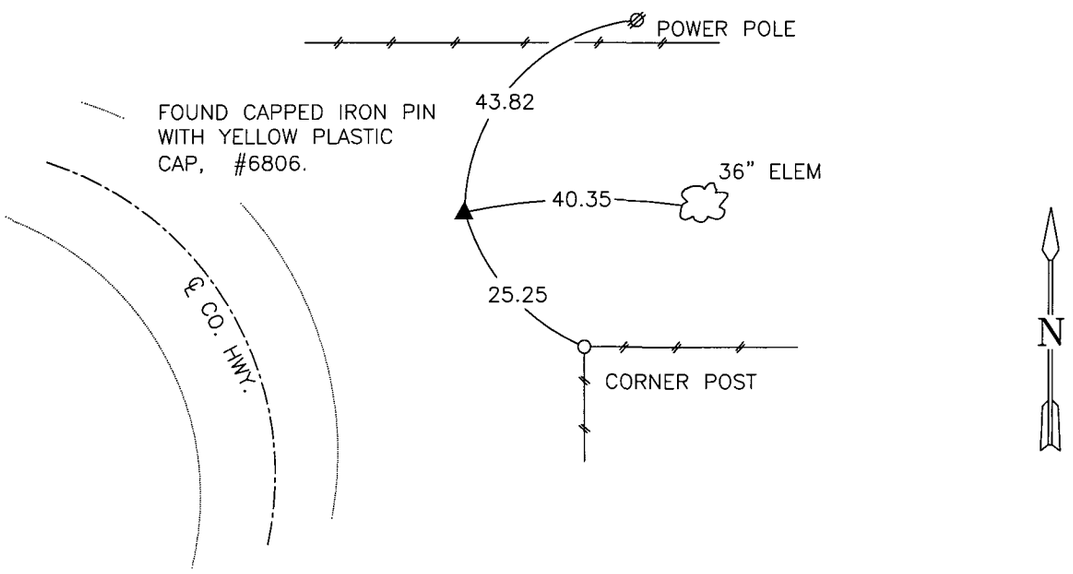

SE. COR., SE. 1/4, SW. 1/4, SEC. 15

NOTE: ALL TIES TO "X" NAILS UNLESS NOTED

LICENSED PROFESSIONAL ENGINEER & LAND SURVEYOR
MICHAEL JAMES HACKETT
14672
IOWA

I hereby certify that this land surveying document was prepared and the related survey work was performed by me or under my direct personal supervision and that I am a duly Licensed Land Surveyor under the laws of the State of Iowa.

Signed _____ Date 7-8-2010
Michael James Hackett

Iowa license number 14672.
My license renewal date is 12/31/2010.
Pages covered by this seal: 1.

15-04-10-02