

LISA SMITH, COUNTY RECORDER  
MADISON COUNTY IOWA

Daniels Land Surveying, 22598 18th Avenue, New Virginia, IA 50210, 641-449-3259

# UNITED STATES PUBLIC LAND CORNER CERTIFICATE OF

Land Survey Monuments situated in Section 24, Township 75 N, Range 26 W, of the 5th P.M., Madison County, Iowa. Previously recorded in n.a. in County Recorders Office. (book, page, document number, etc.)

(Show reason for preparing this certificate, the evidence and detailed procedures used in establishing the corner positions and monumentation found or placed.)


### Monument Description and Remarks:

Set 1/2" x 24" red plastic capped rebar, #17532 using the mathematical breakdown of the SW 1/4 of Section. Location fit existing boundary fence corner so I accepted the boundary fence.


## PLAN VIEW

(Show a minimum of three reference ties to durable physical objects, relevant monuments and physical conditions that will enable recovery of the corner.)

ALL TIES TO 30d SPIKES UNLESS NOTED

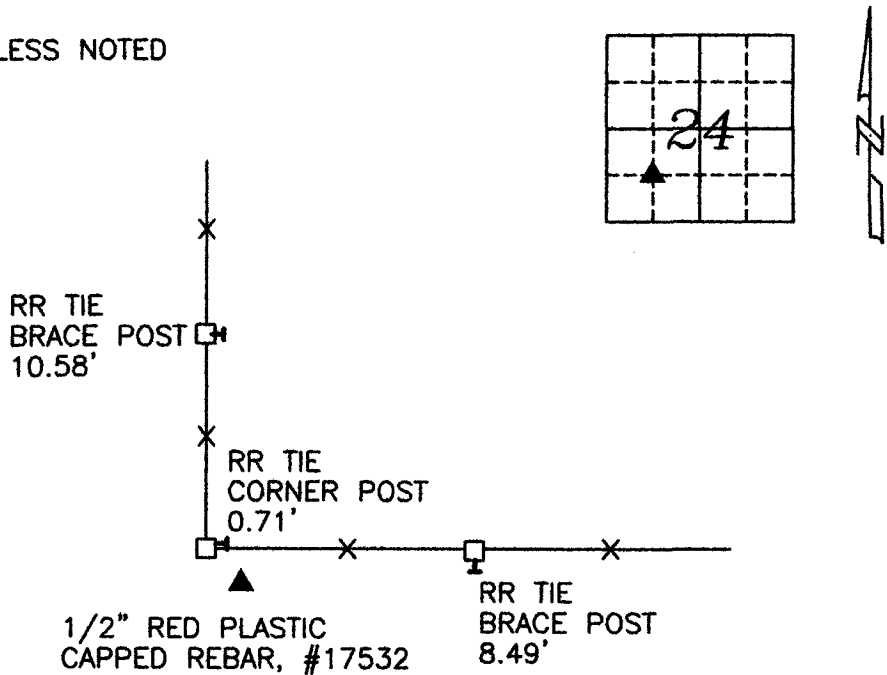

NE COR., SW 1/4, SW 1/4, SEC. 24

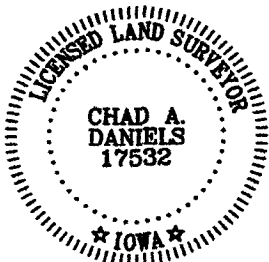

I hereby certify that this land surveying document was prepared and the related survey work was performed by me or under my direct personal supervision and that I am a duly licensed Land Surveyor under the laws of the State of Iowa.

Signature: Chad A. Daniels Date: 8/15/10  
Chad A. Daniels

License number 17532  
My license renewal date is December 31, 2010