Document 2009 71
Book 2009 Page 71 Type 06 043 Pages 1
Date 1/08/2009 Time 3:27 PM
Rec Amt $7.00

INDX ✓
ANNO
SCAN

LISA SMITH. COUNTY RECORDER
MADISON IOWA

CHEK

VANCE & HOCHSTETLER, P.C., CONSULTING ENGINEERS, WINTERSET, IOWA (515) 462-3995
CHARLES T. VANCE, 110 West Green St., Winterset, Iowa, 50273
JAMES M HOCHSTETLER, 110 West Green St., Winterset, Iowa 50273

08-1595

UNITED STATES PUBLIC LAND SURVEY CORNER CERTIFICATE


Land Survey Monuments situated in Section 10, Township 75 N, Range 29 W, of the Fifth Principal Meridian, MADISON County, Iowa.
Previously recorded in _____ in County Recorder's Office.
(book, page, document number, etc.)

(Show reason for preparing this certificate, the evidence and detailed procedures used in establishing the the corner positions and monumentation found or placed.)

Monument Description and Remarks: E¼ COR - Set yellow CIR #6808 3" deep. 1960 road plans indicate an iron bar set and noted as P.I. Sta 95+28.9 which was in line with ℄ Co. Rd. East and property line fence West. We could not find iron bar but we found P.O.T. & P.I. North & used them to set CIR. which matched ℄ Rd & fence. SE COR NE¼ NE¼ - Set yellow CIR #6808 3" deep on line between found NE COR & set E¼ Cor in line with property line fence West.

PLAN - VIEW

(Show a minimum of three reference ties to durable physical objects, relevant monuments and physical conditions that will enable recovery of the corner.)

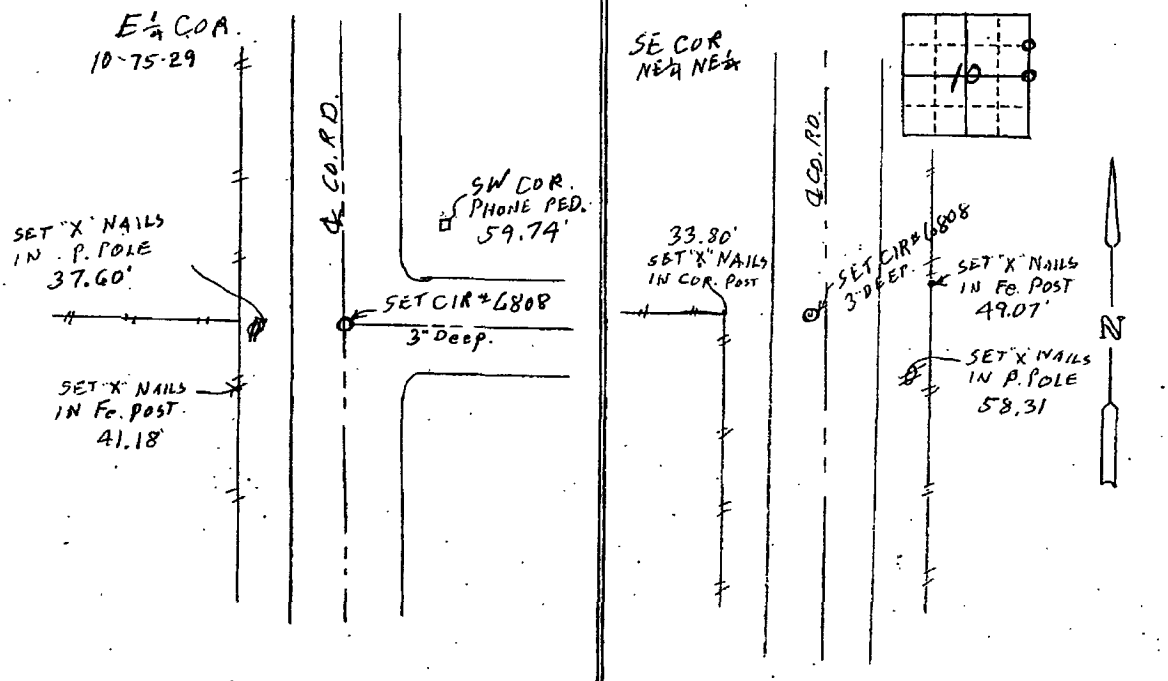

LICENSED LAND SURVEYOR
J. M. HOCHSTETLER
#6808
IOWA

I hereby certify that this land surveying document was prepared and the related survey work was performed by me or under my direct personal supervision and that I am a duly licensed Land Surveyor under the laws of the State of Iowa.

J.M. Hochstetler
J.M. HOCHSTETLER
License number 6808 Date 1/8/09
My license renewal date is December 31, 2009
Pages or sheets covered by this seal: 1

List Corners to be Indexed

Corners	Section	Twp	Range
E¼ COR	10	75N	29W
SE COR. NE¼ NE¼	10	75N	29W