Document 2009 501

Book 2009 Page 501 Type 06 043 Pages 1
Date 2/23/2009 Time 12:15 PM
Rec Amt $7.00

INDX ✓
ANNO
SCAN

LISA SMITH. COUNTY RECORDER
MADISON IOWA

CHEK

VANCE & HOCHSTETLER, P.C., CONSULTING ENGINEERS, WINTERSET, IOWA (515) 462-3995
CHARLES T. VANCE, 110 West Green St., Winterset, Iowa, 50273
JAMES M HOCHSTETLER, 110 West Green St., Winterset, Iowa 50273

09-135.


UNITED STATES PUBLIC LAND SURVEY CORNER CERTIFICATE OF

Land Survey Monuments situated in Section 20, Township 77 N, Range 27W, of the Fifth Principal Meridian, MADISON County, Iowa.
Previously recorded in _____ in County Recorder's Office.
(book, page, document number, etc.)

(Show reason for preparing this certificate, the evidence and detailed procedures used in establishing the the corner positions and monumentation found or placed.)
Monument Description and Remarks: SW COR SE¼SE¼ - Set yellow CIR #6808 on line between found certified SW Cor. of Section and an old Three-way property fence corner at the S¼ Cor and in line with an old property line fence North.
NW Cor. SE¼SE¼ - Set yellow CIR #6808 at old property line fence corner.

PLAN - VIEW

(Show a minimum of three reference tie to durable physical objects, relevant monuments and physical conditions that will enable recovery of the corner.)

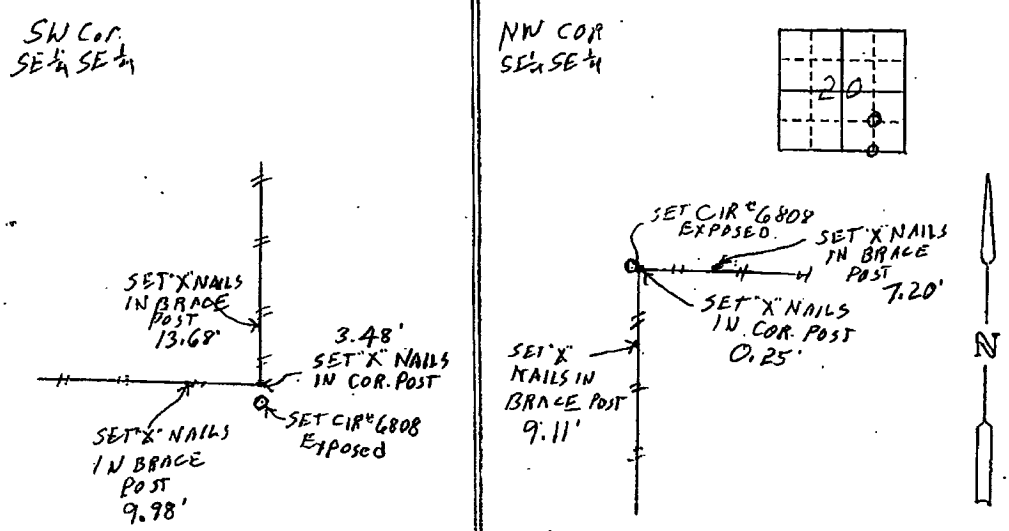

LICENSED LAND SURVEYOR
J. M. HOCHSTETLER #6808
IOWA

I hereby certify that this land surveying document was prepared and the related survey work was performed by me or under my direct personal supervision and that I am a duly licensed Land Surveyor under the laws of the State of Iowa.

J.M. HOCHSTETLER
License number 6808 Date 2/19/09
My license renewal date is December 31 2009
Pages or sheets covered by this seal: 1

List Corners to be Indexed

Corners	Section	Twp	Range
SW COR SE¼ SE¼	20	77	27
NW COR SE¼ SE¼	20	77	27