Document 2010 2158

Book 2010 Page 2158 Type 06 043 Pages 1
Date 9/09/2010 Time 2:28 PM
Rec Amt $9.00

INDX ✓
ANNO
SCAN
CHEK

LISA SMITH, COUNTY RECORDER
MADISON COUNTY IOWA

VANCE & HOCHSTETLER, P.C. CONSULTING ENGINEERS, WINTERSET, IOWA (515)462-3995

D-785 CHARLES T. VANCE, 110 WEST GREEN ST., WINTERSET, IOWA 50273
JAMES M. HOCHSTETLER, 110 WEST GREEN ST., WINTERSET, IOWA 50273

UNITED STATES PUBLIC LAND SURVEY CORNER CERTIFICATE

OF


Land Survey Monuments situated in Section 5, Township 74 North, Range 27 West, of the Fifth Principal Meridian, Madison County, Iowa.
Previously recorded in N/A in County Recorder's Office.
(book, page, document number, etc.)

(Show reason for preparing this certificate, the evidence and detailed procedures used in establishing the corner positions and monumentation found or placed.)


Monument Description and Remarks: SE. Cor. SW¼ SW¼; Set C.I.R. #5041 on Section Line and in Line with Property Line Fence North. NE. Cor. SW¼ SW¼; Set C.I.R. #5041 at intersection of fence south and fence East on property lines; NW. Cor., SW¼ SW¼; Set C.I.R. #5041 on Section Line at mid-point between SW. Section Cor. and West Quarter Cor.


PLAN - VIEW


(Show a minimum of three reference ties to durable physical objects, relevant monuments and physical conditions that will enable recovery of the corner.)

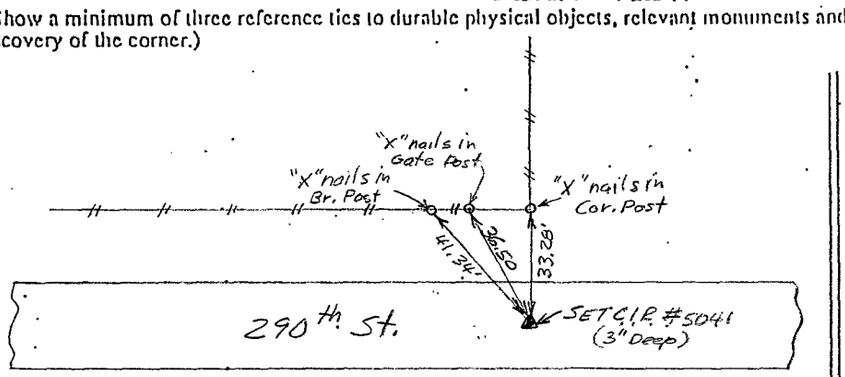

Ref. to SE. Cor., SW.¼ SW.¼, Sec. 5, T74N, R27W.

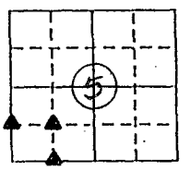

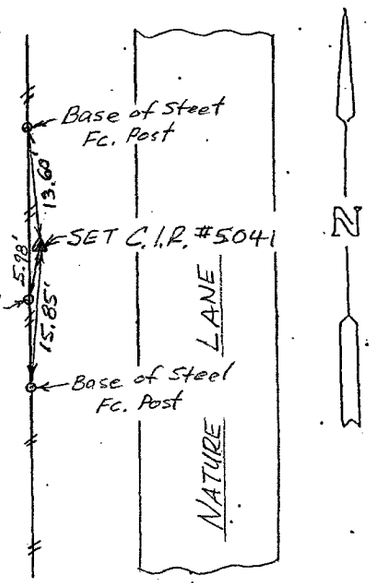

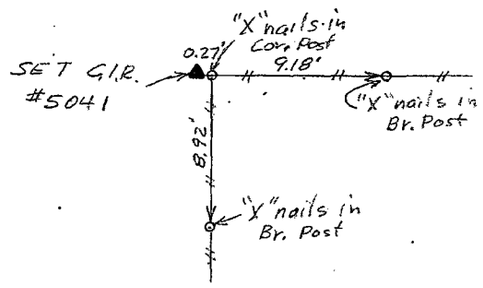

Ref. to NE. Cor., SW¼ SW¼ Sec. 5, T74N, R27W.

Ref. to NW. Cor., SW¼ SW¼ Sec. 5, T74N, R27W.

PROFESSIONAL ENGINEER LICENSED CHARLES T. VANCE 5041 I.O.W.A. LAND SURVEYOR

I hereby certify that this land surveying document was prepared and the related survey work was preformed by me or under my direct personal supervision and that I am a duly Licensed Land Surveyor under the laws of the State of Iowa.

Charles T. Vance 9/03/2010
Charles T. Vance, PE & PLS Date

License No. 5041

My License renewal date is 31, December 2011

List Corners to be Indexed

Corners	Section	Twp	Range
SE. COR. SW¼ SW¼	5	T 74 N	R 27 W.
NE. COR. SW¼ SW. ¼	5	T74N	R27W.
NW. COR SW¼ SW¼	5	T74N	R27W