

INDX ✓
ANNO
SCAN
CHEK


LISA SMITH, COUNTY RECORDER
MADISON IOWA

VANCE & HOCHSTETLER, P.C. • CONSULTING ENGINEERS • WINTERSSET, IOWA • 50273

CHARLES T. VANCE • 110 WEST GREEN ST., WINTERSSET, IOWA • (515) 462-3995
JAMES M HOCHSTETLER • 110 WEST GREEN ST., WINTERSSET, IOWA • FAX: (515) 462 9845

09-256


PLAT OF SURVEY IN THE NORTHEAST QUARTER OF THE SOUTHEAST QUARTER OF SECTION 3, TOWNSHIP 75 NORTH, RANGE 29 WEST OF THE 5TH P.M., MADISON COUNTY, IOWA OWNED BY DAVID & DEBRA HAYMOND.

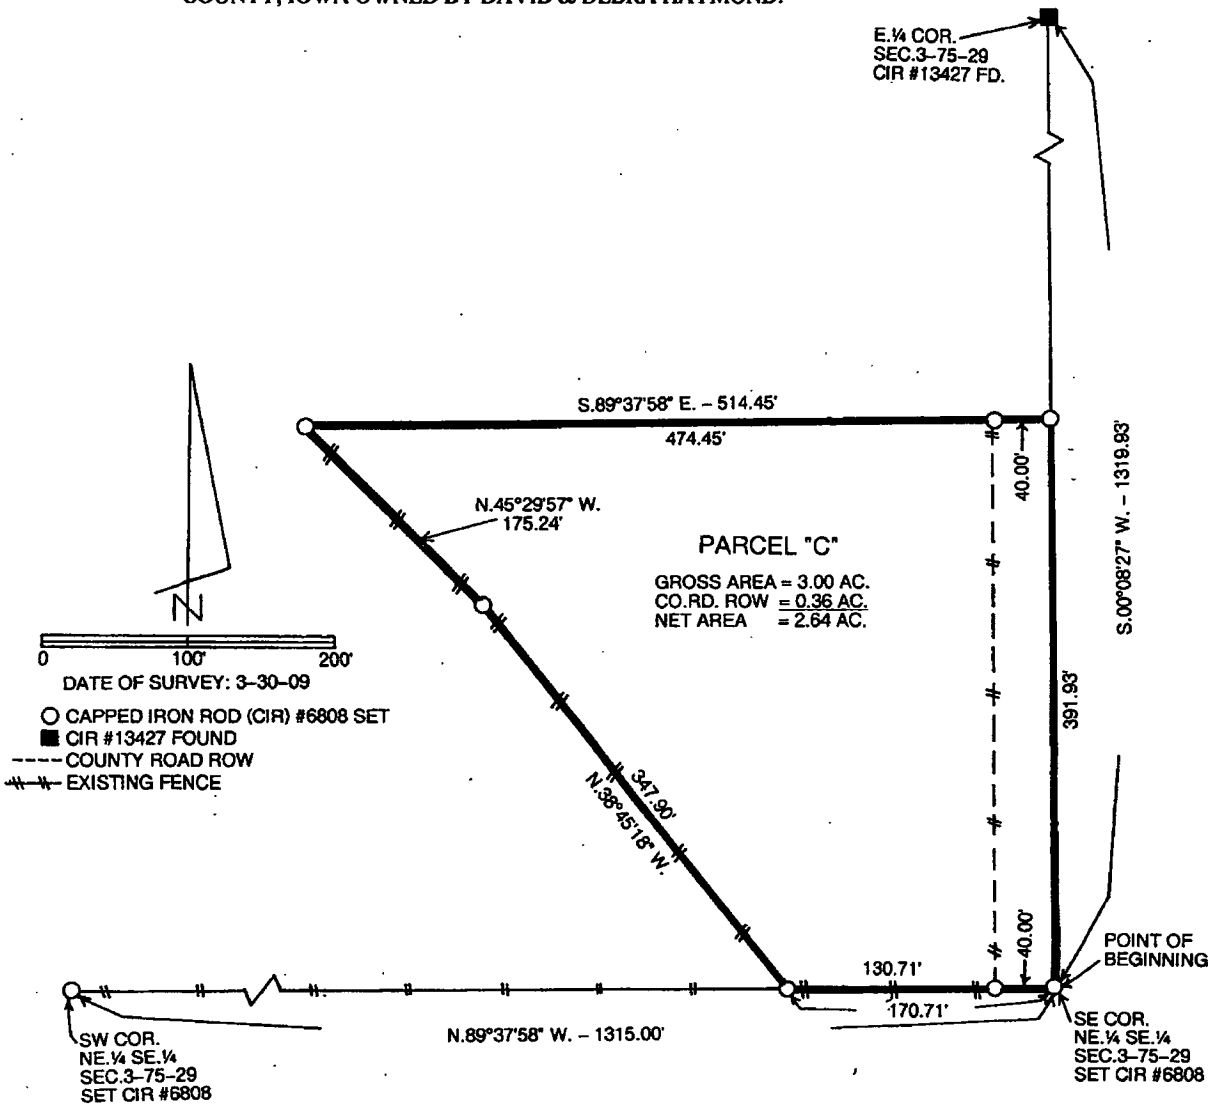

LEGAL DESCRIPTION:

Parcel "C" in the Northeast Quarter of the Southeast Quarter of Section 3, Township 75 North, Range 29 West of the 5th P.M., Madison County, Iowa more particularly described as follows:

Beginning at the Southeast Corner of the Northeast Quarter of the Southeast Quarter of Section 3, Township 75 North, Range 29 West of the 5th P.M., Madison County, Iowa thence North 89°37'58" West 170.71 feet along the South line of said Northeast Quarter of the Southeast Quarter; thence North 38°45'18" West 347.90 feet; thence North 45°29'57" West 175.24 feet; thence South 89°37'58" East 514.45 feet to a point on the East line of said Northeast Quarter of the Southeast Quarter; thence South 00°08'27" West 391.93 feet to the Point of Beginning containing 3.00 acres including 0.36 acres of County Road right-of-way.

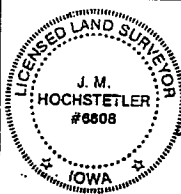
 I hereby certify that this land surveying document was prepared and the related survey work was performed by me or under my direct personal supervision and that I am a duly licensed Land Surveyor under the laws of the State of Iowa.

J.M. Hochstetler
 J.M. HOCHSTETLER
 License number 6808 Date 4/31/09
 My license renewal date is December 31, 2009
 Pages or sheets covered by this seal: 1