Document 2009 1089

Book 2009 Page 1089 Type 06 043 Pages 1
Date 4/14/2009 Time 11:04 AM
Rec Amt $7.00

INDX ✓
ANNO
SCAN

LISA SMITH. COUNTY RECORDER
MADISON IOWA

CHEK

VANCE & HOCHSTETLER, P.C., CONSULTING ENGINEERS, WINTERSET, IOWA (515) 462-3995
CHARLES T. VANCE, 110 West Green St., Winterset, Iowa, 50273
JAMES M HOCHSTETLER, 110 West Green St., Winterset, Iowa 50273

09-255

UNITED STATES PUBLIC LAND SURVEY CORNER CERTIFICATE

OF

Land Survey Monuments situated in Section 3, Township 75 N, Range 29W, of the Fifth Principal Meridian, MADISON County, Iowa.


Previously recorded in _____ In County Recorder's Office.
(book, page, document number, etc.)


(Show reason for preparing this certificate, the evidence and detailed procedures used in establishing the the corner positions and monumentation found or placed.)


Monument Description and Remarks: E¼ Cor. Found CIR #13427 set by Boldman but not tied. In line with property line fence East and an old fence to the West and at the approximate ℄ of road surface. Could not find evidence of stone and bolt shown in old ties. Accepted location. SW Cor NE¼ SE¼ - Set yellow CIR #6808 at 3-way property line fence Corner. SE Cor NE¼ SE¼ - Set yellow CIR #6808 to replace a found nail in line with property line fence West and on line between E¼ Cor. & SE Cor.

PLAN - VIEW

(Show a minimum of three reference ties to durable physical objects, relevant monuments and physical conditions that will enable recovery of the corner.)

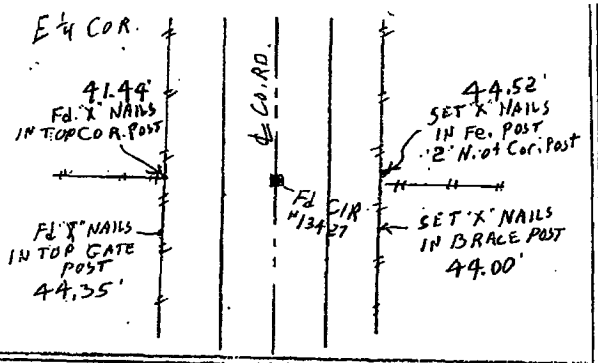

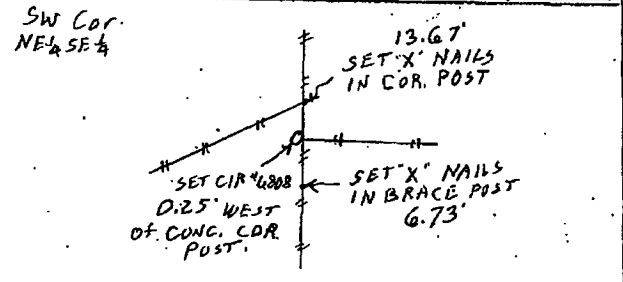

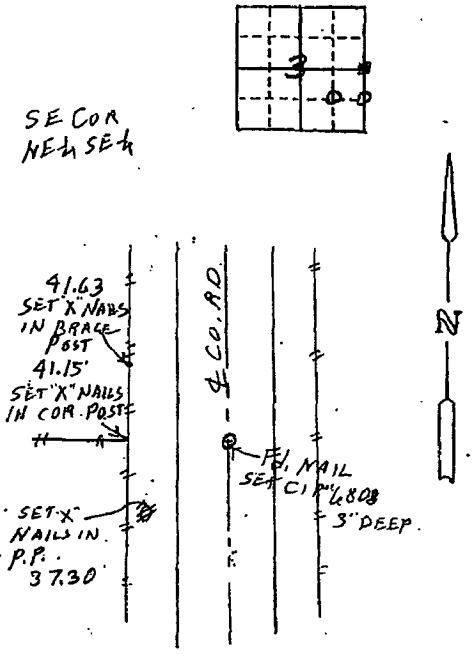

LICENSED LAND SURVEYOR
J. M. HOCHSTETLER #6808
IOWA

I hereby certify that this land surveying document was prepared and the related survey work was performed by me or under my direct personal supervision and that I am a duly licensed Land Surveyor under the laws of the State of Iowa.

J.M. Hochstetler

J.M. HOCHSTETLER
License number 6808 Date 3/31/09
My license renewal date is December 31, 2009
Pages or sheets covered by this seal: 1

List Corners to be Indexed

Corners	Section	Twp	Range
E¼ COR	3	75N	29W
SW COR NE¼ SE¼	3	75N	29W
SE COR NE¼ SE¼	3	75N	29W.