Document 2009 1484

Book 2009 Page 1484 Type 06 043 Pages 1
Date 5/13/2009 Time 11:56 AM
Rec Amt $7.00

INDX ✓
ANNO
SCAN

LISA SMITH, COUNTY RECORDER
MADISON COUNTY IOWA

CHEK

Prepared by: Boldman Surveying Consultants Address: 521 West Green Street, Winterset, Ia. 50273 Phone: (515)462-9242

## UNITED STATES PUBLIC LAND SURVEY CORNER CERTIFICATE FOR

Land survey monuments situated in Section 20, Township 76 Range 26, of the Fifth Principal Meridian, Madison County, Iowa.

Previously recorded in None found in County Recorder's Office.


(Show reason for preparing this certificate, the evidence and detailed procedures used in establishing the corner positions & monumentation found or placed.)


MONUMENT DESCRIPTION AND REMARKS: S 1/4- Found 4x6" lime stone. Set 1/2" pin West edge.

### PLAN - VIEW

(Show a minimum of three reference ties to durable physical objects, relevant monuments and physical conditions that will enable recovery of the corner.)

S 1/4- Found 4x6" lime stone. Set 1/2" pin West edge.

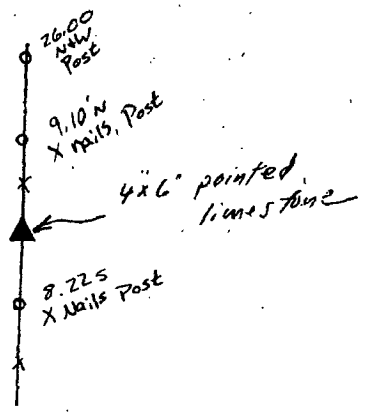


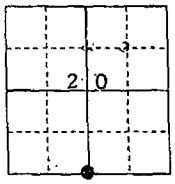



SEAL

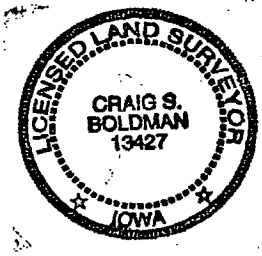


SLSI-3/98

I hereby certify that this land surveying document was prepared and the related survey work was performed by me or under my direct personal supervision and that I am a duly licensed Land Surveyor under the laws of the State of Iowa.

Signature 4/14/09 Date

Typed/Printed Name: Craig S. Boldman

License Number: 13427

My license renewal date is December 31, 2010

Pages or sheets covered by this seal:

Corners to be Indexed

| Corners | Section | Twp. | Range |
|---|---|---|---|
| S 1/4 | 20 | 76 | 26 |

Job # 09010