


INDEX
ANNO
SCAN
CHECK

LISA SMITH, COUNTY RECORDER
MADISON COUNTY IOWA

● IRON PIN FOUND #6808
*(PLATTED DIMENSION)

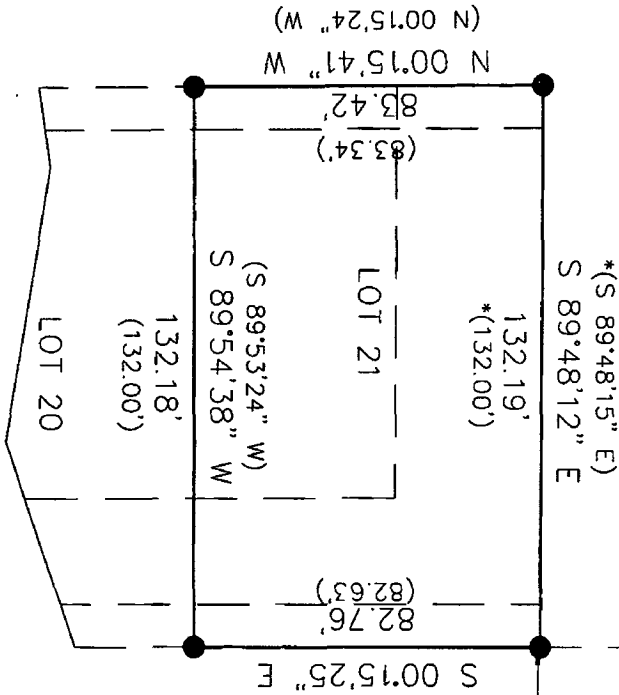

NORTH 9TH AVENUE

66.0ft

MILLS STREET



LEGAL DESCRIPTION

Lot 21 in Corkrean & Wotis Addition Plat 2 on
official plat, now in and forming a part of the Town
of Winterset, Madison County, Iowa.



Retracement survey

REQUESTED BY	Earl White	BOLDMAN SURVEYING CONSULTANTS, LLC
SURVEYED	4/10/09	SCALE 1"=50' 521 West Green Street WINTERSSET, IA 50279 (515)482-9242
PROJECT NO.	09011	DATE 04/11/09 OWNER Earl White

I HEREBY CERTIFY THAT THIS LAND SURVEYING DOCUMENT WAS
PREPARED IN ACCORDANCE WITH THE IOWA SURVEYING AND
PLATTING ACT AND THAT I AM A DULY LICENSED LAND SURVEYOR UNDER THE LAWS OF
THE STATE OF IOWA.
NAME: CRAIG S. BOLDMAN
DATE: 4/10/09
MY LICENSE RENEWAL DATE IS: DECEMBER 31, 2010

