Document 2009 1824
Book 2009 Page 1824 Type 06 043 Pages 1
Date 6/10/2009 Time 2:22 PM
Rec Amt $7.00

INDX
ANNO
SCAN

LISA SMITH. COUNTY RECORDER
MADISON COUNTY IOWA

CHEK

VANCE & HOCHSTETLER, P.C., CONSULTING ENGINEERS, WINTERSET, IOWA (515) 462-3995
CHARLES T. VANCE, 110 West Green St., Winterset, Iowa, 50273
JAMES M HOCHSTETLER, 110 West Green St., Winterset, Iowa 50273

09-393

# UNITED STATES PUBLIC LAND SURVEY CORNER CERTIFICATE

OF


Land Survey Monuments situated in Section 25, Township 75 N, Range 27 W, of the Fifth Principal Meridian, MADISON County, Iowa.
Previously recorded in _____ In County Recorder's Office.
(book, page, document number, etc.)


(Show reason for preparing this certificate, the evidence and detailed procedures used in establishing the the corner positions and monumentation found or placed.)

Monument Description and Remarks: NE COR - Found Bridge Spike 2" deep at approximate Centerline of North-South road in line with Centerline of road West.
N¼Cor - Set CIR #6808 at point ⅓rd of distance from found NW Cor NE¼ NW¼ to NW Cor at split of roadway, Could not find anything at NW Cor Sec. Center - Set yellow CIR #6808 at point on line between found SW Cor SE¼ NW¼ and E¼ Cor at ⅓rd total distance between found points.

## PLAN - VIEW

(Show a minimum of three reference ties to durable physical objects, relevant monuments and physical conditions that will enable recovery of the corner.)

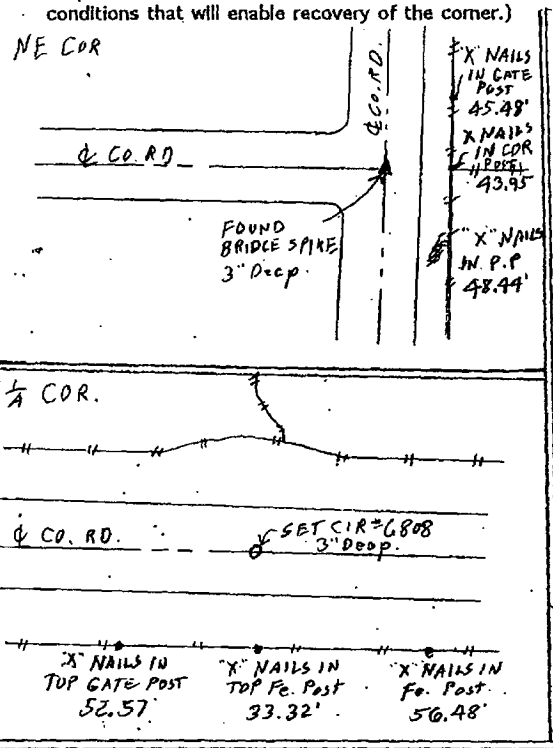

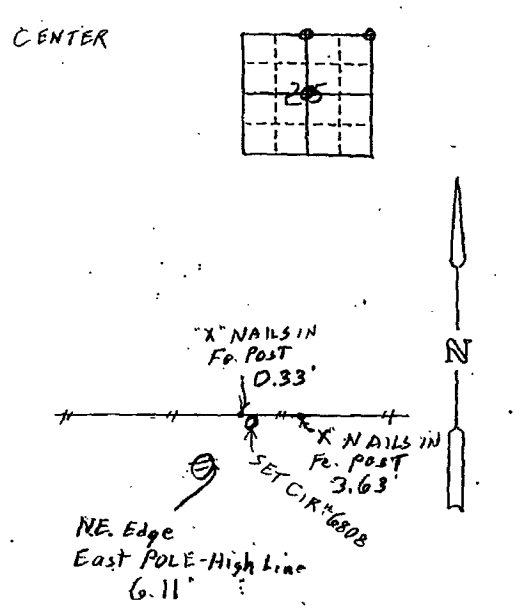
LICENSED LAND SURVEYOR
J. M. HOCHSTETLER
#6808
IOWA

I hereby certify that this land surveying document was prepared and the related survey work was performed by me or under my direct personal supervision and that I am a duly licensed Land Surveyor under the laws of the State of Iowa.

J.M. HOCHSTETLER
License number 6808 Date 5/28/09
My license renewal date is December 31, 2009
Pages or sheets covered by this seal: 1

List Corners to be Indexed

| Corners | Section | Twp | Range |
|---|---|---|---|
| NE COR | 25 | 75N | 27W |
| N¼ Cor | 25 | 75N | 27W |
| CENTER | 25 | 75N | 27W |