Document 2009 1825

Book 2009 Page 1825 Type 06 043 Pages 1
Date 6/10/2009 Time 2:22 PM
Rec Amt $7.00

INDX
ANNO
SCAN

LISA SMITH. COUNTY RECORDER
MADISON COUNTY IOWA

CHEK

VANCE & HOCHSTETLER, P.C., CONSULTING ENGINEERS, WINTERSET, IOWA (515) 462-3995
CHARLES T. VANCE, 110 West Green St., Winterset, Iowa, 50273
JAMES M HOCHSTETLER, 110 West Green St., Winterset, Iowa 50273

09-355

UNITED STATES PUBLIC LAND SURVEY CORNER CERTIFICATE

OF

Land Survey Monuments situated in Section 12, Township 77 N, Range 26 W, of the Fifth Principal Meridian, MADISON County, Iowa.


Previously recorded in _____ (book, page, document number, etc.) In County Recorder's Office.


(Show reason for preparing this certificate, the evidence and detailed procedures used in establishing the the corner positions and monumentation found or placed.)

Monument Description and Remarks: CENTER - Set yellow CIR "6808 exposed at 4-way intersection of property line fences. We shot all 4 1/4 Corners and intersected for a calculated Center but it missed the the E/W Fence by 6 1/2' South and the N/S fence by 2' West. All 4 of the Certified 1/4 Corners were set in line with old property line fences so we decided the old established fence corner was the best evidence of where the corner should b NW Cor NE1/4 SW1/4 - Set yellow CIR "6808 at mid point on line between Center & W 1/4 Corner.

PLAN - VIEW

(Show a minimum of three reference ties to durable physical objects, relevant monuments and physical conditions that will enable recovery of the corner.)

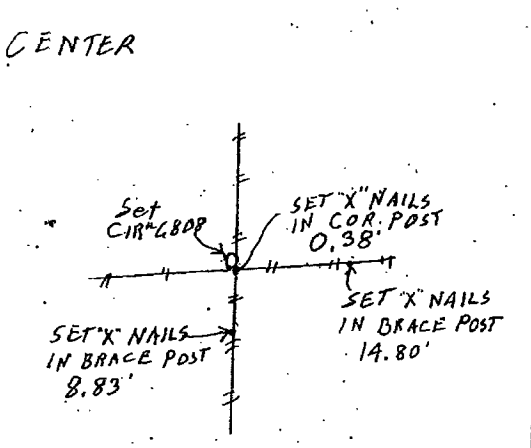

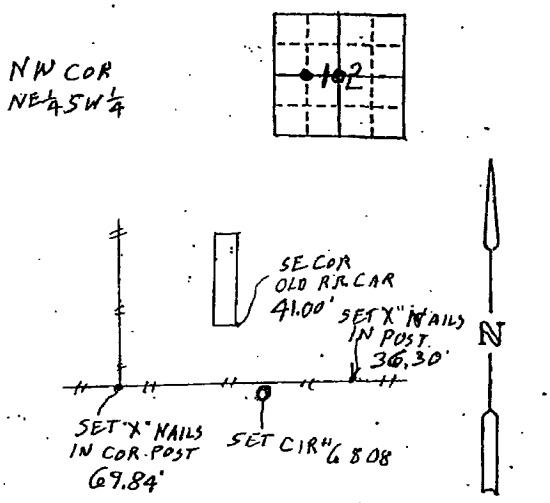

LICENSED LAND SURVEYOR
J. M. HOCHSTETLER
#6808
IOWA

I hereby certify that this land surveying document was prepared and the related survey work was performed by me or under my direct personal supervision and that I am a duly licensed Land Surveyor under the laws of the State of Iowa.

J.M. HOCHSTETLER
License number 6808 Date 6/10/09
My license renewal date is December 31, 2009
Pages or sheets covered by this seal: 1

List Corners to be Indexed

Corners	Section	Twp	Range
CENTER	12	77N	26W
NW COR NE1/4 SW1/4	12	77N	26W