Document 2009 1818

Book 2009 Page 1818 Type 06 043 Pages 1
Date 6/10/2009 Time 2:13 PM
Rec Amt $7.00

INDX ✓
ANNO
SCAN
CHEK

LISA SMITH, COUNTY RECORDER
MADISON COUNTY IOWA

VANCE & HOCHSTETLER,P.C. CONSULTING ENGINEERS, WINTERSET, IOWA (515)462-3995
CHARLES T. VANCE, 110 WEST GREEN ST.,WINTERSET, IOWA 50273
JAMES M. HOCHSTETLER, 110 WEST GREEN ST., WINTERSET, IOWA 50273

UNITED STATES PUBLIC LAND SURVEY CORNER CERTIFICATE

OF


Land Survey Monuments situated in Section 8, Township 75 North, Range 27 West, of the Fifth Principal Meridian, Madison County, Iowa.
Previously recorded in N/A (book, page, document number, etc.) in County Recorder's Office.


(Show reason for preparing this certificate, the evidence and detailed procedures used in establishing the corner positions and monumentation found or placed.)

Monument Description and Remarks: NE. Cor. SE.¼ SE.¼, set yellow capped iron rod on line and at mid-distance between found E.¼ Cor. and SE. Cor., NW. Cor. SE.¼ SE.¼, set yellow capped iron rod at property line fence corner.

PLAN - VIEW

(Show a minimum of three reference ties to durable physical objects, relevant monuments and physical conditions that will enable recovery of the corner.)

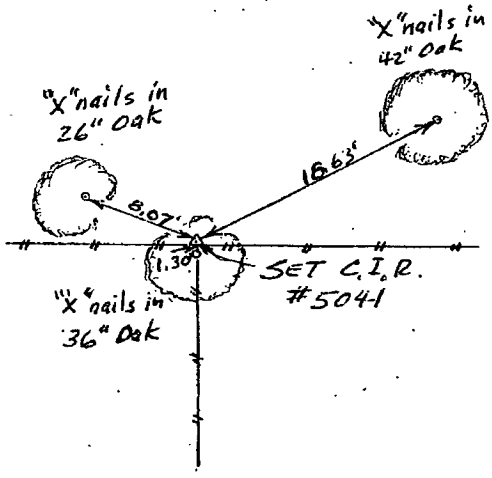

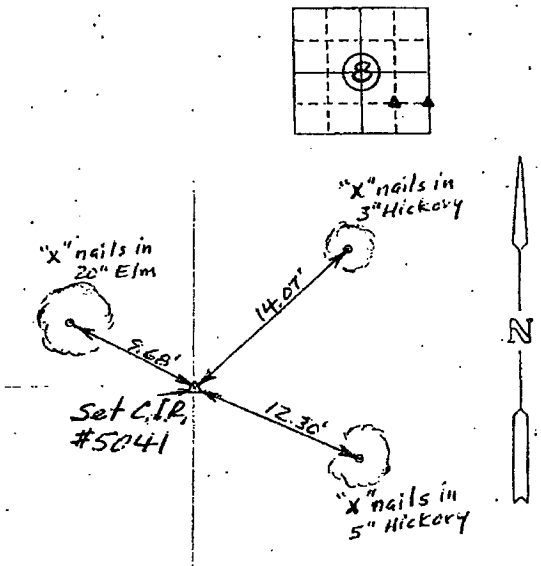

Ref. to NW. Cor. SE.¼ SE.¼ Section 8, T75N, R27W.

Ref. to NE. Cor. SE.¼ SE.¼ Section 8, T75N, R27W

PROFESSIONAL ENGINEER LICENSED CHARLES T. VANCE 5041 IOWA LAND SURVEYOR

I hereby certify that this land surveying document was prepared and the related survey work was performed by me or under my direct personal supervision and that I am a duly Licensed Land Surveyor under the laws of the State of Iowa.

Charles T. Vance 29 May 2009
Charles T. Vance, PE & PLS Date

License No. 5041

My License renewal date is 31, December 2009

List Corners to be Indexed

Corners	Section	Twp	Range
NE. Cor. SE¼ SE¼	8	75	27
NW. Cor. SE.¼ SE.¼	8	75	27