Document 2009 1820
Book 2009 Page 1820 Type 06 043 Pages 1
Date 6/10/2009 Time 2:18 PM
Rec Amt $7.00

INDX ✓
ANNO
SCAN
CHEK

LISA SMITH. COUNTY RECORDER
MADISON COUNTY IOWA

VANCE & HOCHSTETLER, P.C., CONSULTING ENGINEERS, WINTERSET, IOWA (515) 462-3995
CHARLES T. VANCE, 110 West Green St., Winterset, Iowa, 50273
JAMES M HOCHSTETLER, 110 West Green St., Winterset, Iowa 50273

09-525

UNITED STATES PUBLIC LAND SURVEY CORNER CERTIFICATE

OF

Land Survey Monuments situated in Section 21, Township 77N, Range 28W, of the Fifth Principal Meridian, MADISON County, Iowa.
Previously recorded in _____ (book, page, document number, etc.) In County Recorder's Office.


(Show reason for preparing this certificate, the evidence and detailed procedures used in establishing the the corner positions and monumentation found or placed.)


Monument Description and Remarks: SW COR - Found ½" Iron Rod 3" deep as shown on old ties in County Engineer's records.

SE COR SW¼ SW¼ - Found CIR (Unreadable) 2" deep as shown on old ties in County Engineer's records. Our old records indicate the point was set by Cleo McCall L.S 8034

PLAN - VIEW

(Show a minimum of three reference ties to durable physical objects, relevant monuments and physical conditions that will enable recovery of the corner.)

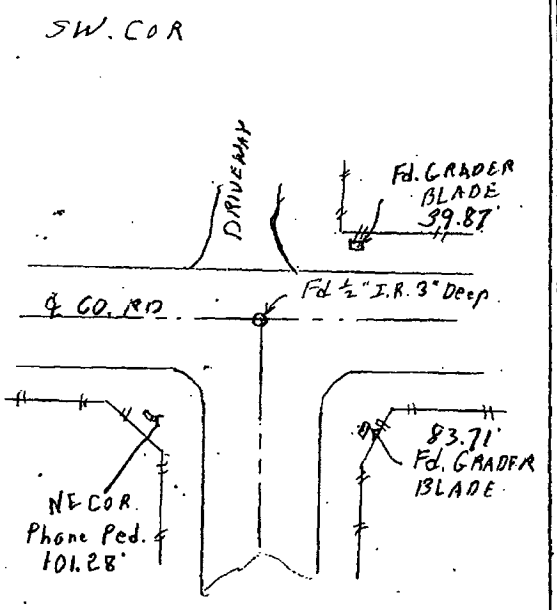

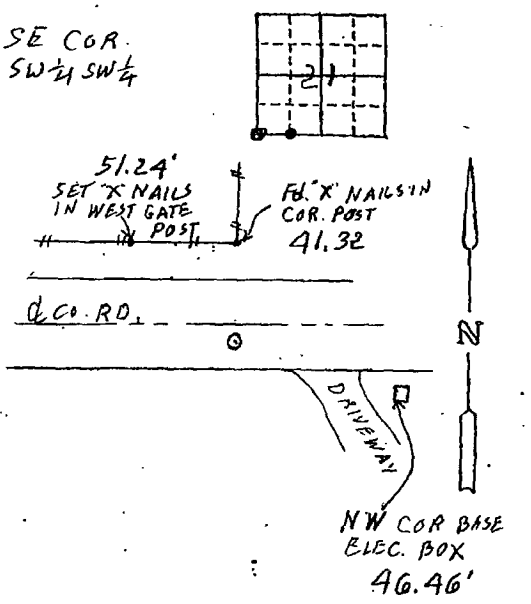

LICENSED LAND SURVEYOR
J. M. HOCHSTETLER
#6808
IOWA

I hereby certify that this land surveying document was prepared and the related survey work was performed by me or under my direct personal supervision and that I am a duly licensed Land Surveyor under the laws of the State of Iowa.

J.M. Hochstetler

J.M. HOCHSTETLER
License number 6808 Date 6/4/09
My license renewal date is December 31, 2009
Pages or sheets covered by this seal: 1

List Corners to be Indexed

Corners	Section	Twp	Range
SW COR	21	77N	28W
SE COR SW¼ SW¼	21	77N	28W