Document 2009 1821
Book 2009 Page 1821 Type 06 043 Pages 1
Date 6/10/2009 Time 2:19 PM
Rec Amt $7 00

INDX
ANNO
SCAN

LISA SMITH. COUNTY RECORDER
MADISON COUNTY IOWA

CHEK

VANCE & HOCHSTETLER, P.C., CONSULTING ENGINEERS, WINTERSET, IOWA (515) 462-3995
CHARLES T. VANCE, 110 West Green St., Winterset, Iowa, 50273
JAMES M HOCHSTETLER, 110 West Green St., Winterset, Iowa 50273

09-485


UNITED STATES PUBLIC LAND SURVEY CORNER CERTIFICATE OF

Land Survey Monuments situated in Section 30, Township 75 N, Range 26 W, of the Fifth Principal Meridian, MADISON County, Iowa.
Previously recorded in _____ In County Recorder's Office.
(book, page, document number, etc.)

(Show reason for preparing this certificate, the evidence and detailed procedures used in establishing the the corner positions and monumentation found or placed.)
Monument Description and Remarks: NE COR SE¼SE¼ - Set yellow CIR #6808 at projection of found Corners at NW Cor SE¼SE¼ and NW Cor SW¼SE¼ and intersection with line from apparent NE Cor SE¼NE¼ and found Stone at SE Cor Sec. 30.

PLAN - VIEW

(Show a minimum of three reference ties to durable physical objects, relevant monuments and physical conditions that will enable recovery of the corner.)

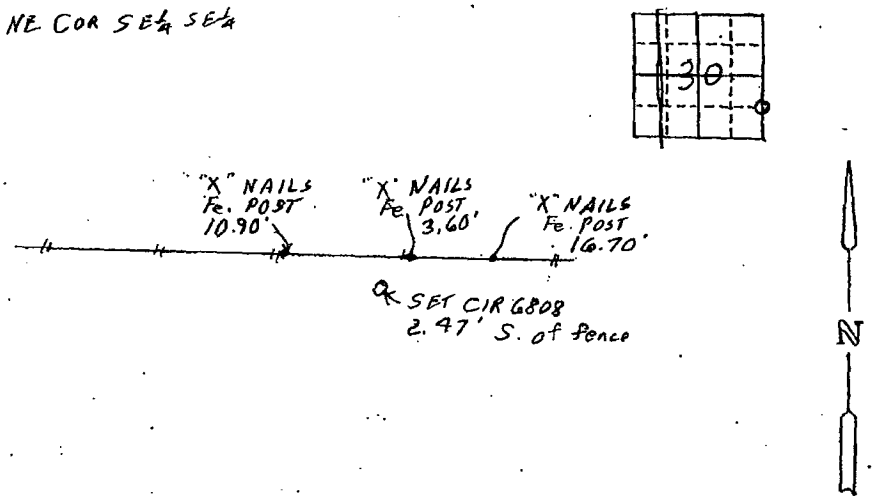

LICENSED LAND SURVEYOR
J. M. HOCHSTETLER #6808
IOWA

I hereby certify that this land surveying document was prepared and the related survey work was performed by me or under my direct personal supervision and that I am a duly licensed Land Surveyor under the laws of the State of Iowa.

J.M. HOCHSTETLER
License number 6808 Date 5/24/09
My license renewal date is December 31, 2009
Pages or sheets covered by this seal: 1

List Corners to be Indexed

Corners	Section	Twp	Range
NE.COR SE¼SE¼	30	75N	26W