Document 2009 1823

Book 2009 Page 1823 Type 06 043 Pages 1
Date 6/10/2009 Time 2:21 PM
Rec Amt $7.00

INDX
ANNO
SCAN

LISA SMITH, COUNTY RECORDER
MADISON COUNTY IOWA

CHEK

VANCE & HOCHSTETLER, P.C., CONSULTING ENGINEERS, WINTERSET, IOWA (515) 462-3995
CHARLES T. VANCE, 110 West Green St., Winterset, Iowa, 50273
JAMES M HOCHSTETLER, 110 West Green St., Winterset, Iowa 50273

09-485

UNITED STATES PUBLIC LAND SURVEY CORNER CERTIFICATE

OF

Land Survey Monuments situated in Section 31, Township 75 N, Range 26 W, of the Fifth Principal Meridian, MADISON County, Iowa.


Previously recorded in _____ in County Recorder's Office.
(book, page, document number, etc.)


(Show reason for preparing this certificate, the evidence and detailed procedures used in establishing the the corner positions and monumentation found or placed.)


Monument Description and Remarks: SE COR NE¼NE¼ - Set yellow CIR #6808 at existing 3-way property Corner fence.
SW Cor NE¼NE¼ - Set yellow CIR #6808 based on a property line fence South and information shown on road construction plans.
NW Cor NE¼ NE¼ - Set yellow CIR #6808 on line between found Stone at NE Section Corner & found S¼ Cor and in line with projection of County road centerline projected North.


PLAN - VIEW

(Show a minimum of three reference ties to durable physical objects, relevant monuments and physical conditions that will enable recovery of the corner.)

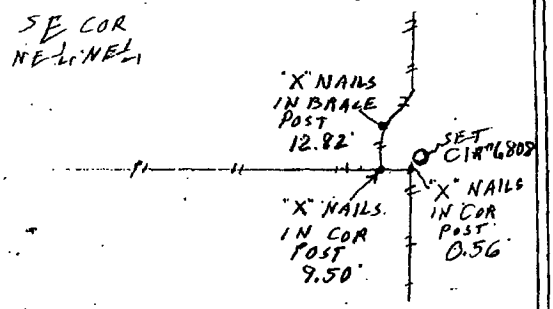

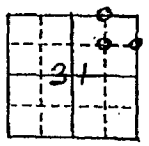

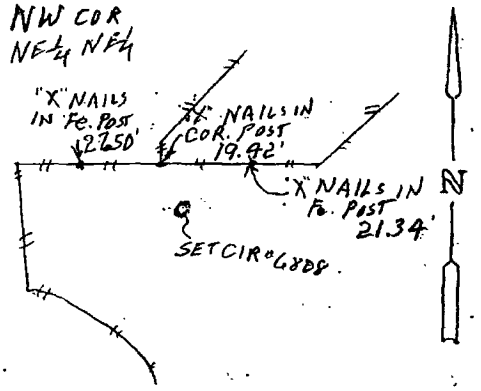

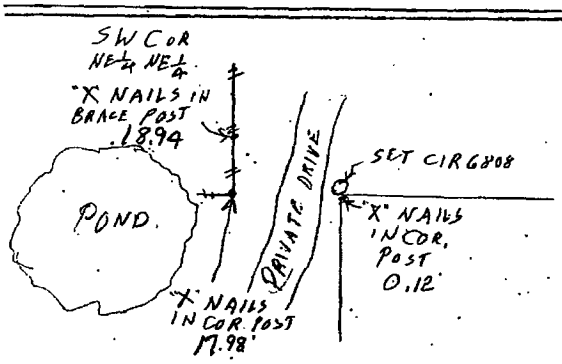

LICENSED LAND SURVEYOR
J. M. HOCHSTETLER
#6808
IOWA

I hereby certify that this land surveying document was prepared and the related survey work was performed by me or under my direct personal supervision and that I am a duly licensed Land Surveyor under the laws of the State of Iowa.

J.M. Hochstetler

J.M. HOCHSTETLER
License number 6808 Date 5/26/09
My license renewal date is December 31 2009
Pages or sheets covered by this seal: 1

List Corners to be Indexed

Corners	Section	Twp	Range
SE COR NE¼ NE¼	31	75N	26W
SW COR NE¼ NE¼	31	75N	26W
NW COR NE¼ NE¼	31	75N	26W