
Document 2009 1665 Book 2009 Page 1665 Type 06 026 Pages I Date 5/29/2009 Time 12:27 PM Rec Amt \$7.00 INDX -ANNO LISA SMITH. COUNTY RECORDER MADISON COUNTY IOWA CHEK

## VANCE & HOCHSTETLER, P.C. • CONSULTING ENGINEERS • WINTERSET. IOWA • 50273

CHARLES T. VANCE • 110 WEST GREEN ST., WINTERSET, IOWA • (515) 462-3995 JAMES M HOCHSTETLER • 110 WEST GREEN ST., WINTERSET, IOWA • FAX: (515) 462 9845

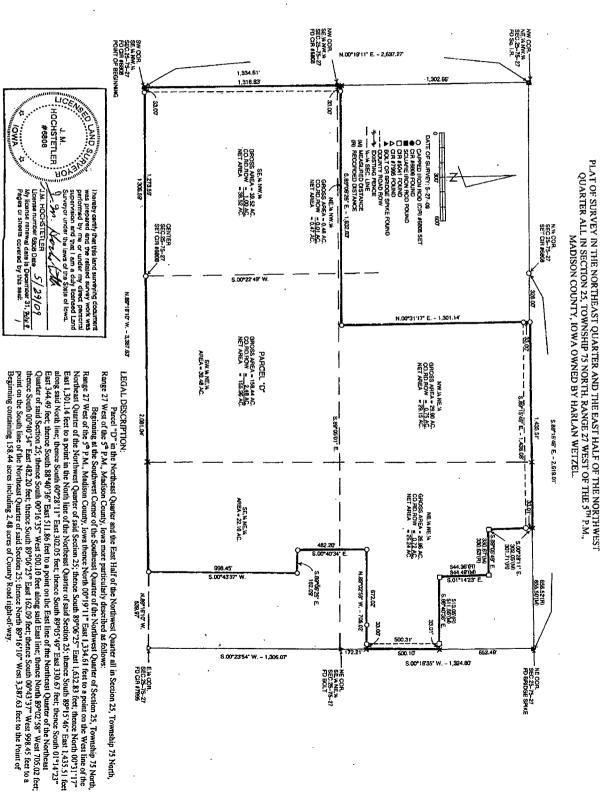

wint on the South line of the Northeast Quarter of said Section 25; thence North 89°16'10" West 3,387.63 feet to the Point of