Document 2010 2393

Book 2010 Page 2393 Type 06 043 Pages 1
Date 10/01/2010 Time 11:04 AM
Rec Amt $9.00

INDX ✓
ANNO
SCAN

LISA SMITH, COUNTY RECORDER
MADISON COUNTY IOWA

CHEK

VANCE & HOCHSTETLER, P.C., CONSULTING ENGINEERS, WINTERSET, IOWA (515) 462-3995
CHARLES T. VANCE, 110 West Green St., Winterset, Iowa, 50273
JAMES M HOCHSTETLER, 110 West Green St., Winterset, Iowa 50273

10-1025

UNITED STATES PUBLIC LAND SURVEY CORNER CERTIFICATE OF


Land Survey Monuments situated in Section 11, Township 75 N, Range 29 W, of the Fifth Principal Meridian, MADISON County, Iowa.
Previously recorded in _____ in County Recorder's Office.
(book, page, document number, etc.)


(Show reason for preparing this certificate, the evidence and detailed procedures used in establishing the the corner positions and monumentation found or placed.)


Monument Description and Remarks: SE COR. SEC. 11-75-29 - Projected a line from E¼ Cor Sec. 14 Through NE COR SE¼SE¼ and equal distance from E¼ Cor Sec 14 & E¼ Sec. 11. Lined up with old fence East. Set yellow CIR #6808 NE Cor SE¼SE¼ - Set yellow CIR #6808 at midpoint on line between found E¼ Cor. and Set SE. Cor. SW Cor. SE¼ SE¼ - Set yellow CIR #6808 equal distance from found NW Cor. NE¼ SE¼ Sec. 11 & found NW Cor. NE¼ NE¼ Sec. 14. Set in existing N. & S. fence.

PLAN - VIEW

(Show a minimum of three reference ties to durable physical objects, relevant monuments and physical conditions that will enable recovery of the corner.)

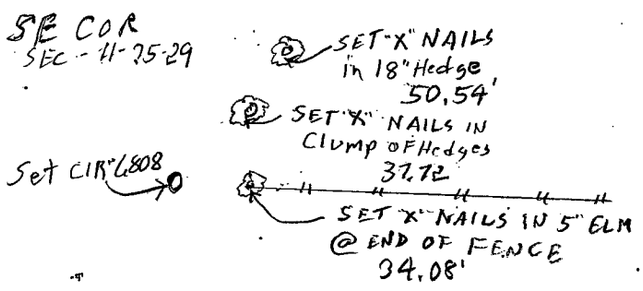

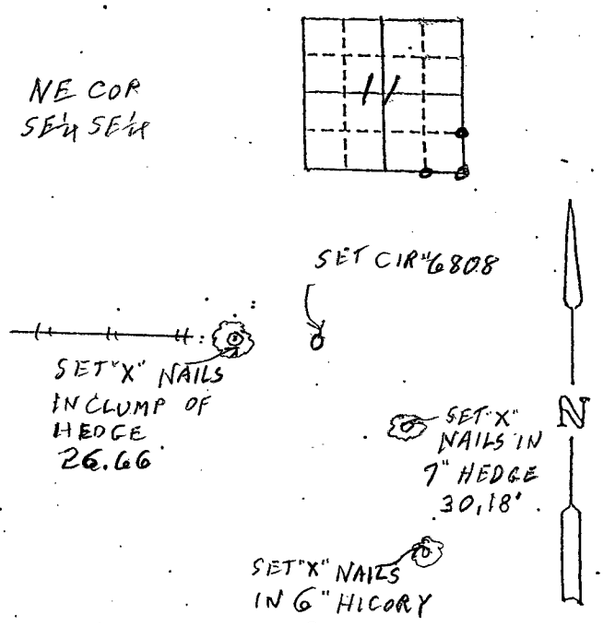

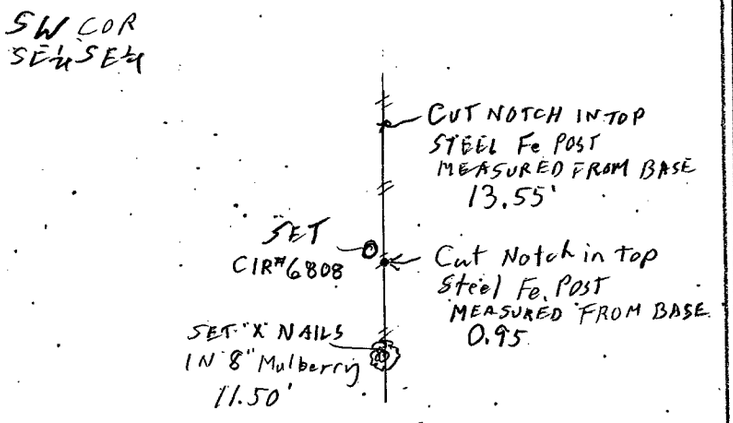

I hereby certify that this land surveying document was prepared and the related survey work was performed by me or under my direct personal supervision and that I am a duly licensed Land Surveyor under the laws of the State of Iowa.

J.M. Hochstetler

J.M. HOCHSTETLER
License number 6808 Date 9/17/10
My license renewal date is December 31, 2011
Pages or sheets covered by this seal: 1

LICENSED LAND SURVEYOR
J. M.
HOCHSTETLER
#6808
IOWA

List Corners to be Indexed

Corners	Section	Twp	Range
SE COR	11	75N	29W
SW COR SE¼ SE¼	11	75N	29W
NE COR SE¼ SE¼	11	75N	29W