



Document 2011 GW389

Book 2011 Page 389 Type 43 001 Pages 3

Date 2/03/2011 Time 3:43 PM

Rec Amt \$.00

INDX
ANNO
SCAN
CHEK

LISA SMITH, COUNTY RECORDER
MADISON COUNTY IOWA

**REAL ESTATE TRANSFER - GROUNDWATER HAZARD STATEMENT
TO BE COMPLETED BY TRANSFEROR**

TRANSFEROR:

Name Rick E. Fenimore and Connie Fenimore

Address 3229 305th LN, Truro, IA 50257
Number and Street or RR City, Town or P.O. State Zip

TRANSFeree:

Name Joshua J. Beck and Heather M. Beck

Address 150 E Prairie St., Truro, IA 50257
Number and Street or RR City, Town or P.O. State Zip

Address of Property Transferred:

Number and Street or RR City, Town, or P.O. State Zip

Legal Description of Property: (Attach if necessary) See Attached

1. Wells (check one)

- There are no known wells situated on this property.
- There is a well or wells situated on this property. The type(s), location(s) and legal status are stated below or set forth on an attached separate sheet, as necessary.

2. Solid Waste Disposal (check one)

- There is no known solid waste disposal site on this property.
- There is a solid waste disposal site on this property and information related thereto is provided in Attachment #1, attached to this document.

3. Hazardous Wastes (check one)

- There is no known hazardous waste on this property.
- There is hazardous waste on this property and information related thereto is provided in Attachment #1, attached to this document.

4. Underground Storage Tanks (check one)

- There are no known underground storage tanks on this property. (Note exclusions such as small farm and residential motor fuel tanks, most heating oil tanks, cisterns and septic tanks, in instructions.)
- There is an underground storage tank on this property. The type(s), size(s) and any known substance(s) contained are listed below or on an attached separate sheet, as necessary.


5. Private Burial Site (check one)

- There are no known private burial sites on this property.
- There is a private burial site on this property. The location(s) of the site(s) and known identifying information of the decedent(s) is stated below or on an attached separate sheet, as necessary.

6. Private Sewage Disposal System (check one)

- All buildings on this property are served by a public or semi-public sewage disposal system.
- This transaction does not involve the transfer of any building.
- There is a building served by private sewage disposal system on this property or a building without any lawful sewage disposal system. A certified inspector's report is attached which documents the condition of the private sewage disposal system and whether any modifications are required to conform to standards adopted by the Department of Natural Resources. A certified inspection report must be accompanied by this form when recording.
- There is a building served by private sewage disposal system on this property. Weather or other temporary physical conditions prevent the certified inspection of the private sewage disposal system from being conducted. The buyer has executed a binding acknowledgment with the county board of health to conduct a certified inspection of the private sewage disposal system at the earliest practicable time and to be responsible for any required modifications to the private sewage disposal system as identified by the certified inspection. A copy of the binding acknowledgment is attached to this form.
- There is a building served by private sewage disposal system on this property. The buyer has executed a binding acknowledgment with the county board of health to install a new private sewage disposal system on this property within an agreed upon time period. A copy of the binding acknowledgment is provided with this form.
- There is a building served by private sewage disposal system on this property. The building to which the sewage disposal system is connected will be demolished without being occupied. The buyer has executed a binding acknowledgment with the county board of health to demolish the building within an agreed upon time period. A copy of the binding acknowledgment is provided with this form. [Exemption #9]
- This property is exempt from the private sewage disposal inspection requirements pursuant to the following exemption [Note: for exemption #9 use prior check box]: _____.
- The private sewage disposal system has been installed within the past two years pursuant to permit number _____.

Information required by statements checked above should be provided here or on separate sheets attached hereto:

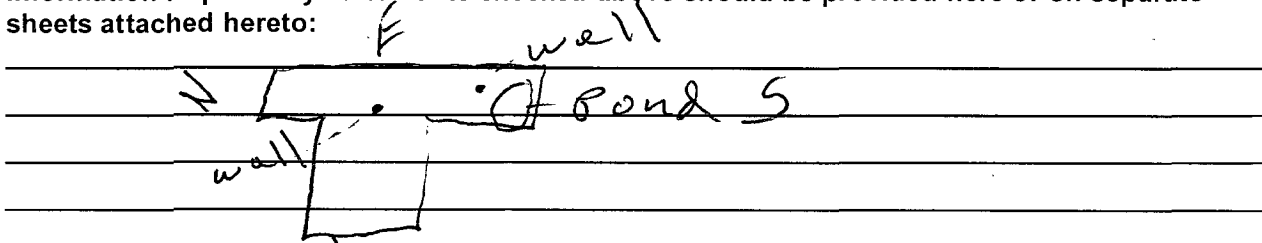

I HEREBY DECLARE THAT I HAVE REVIEWED THE INSTRUCTIONS FOR THIS FORM AND THAT THE INFORMATION STATED ABOVE IS TRUE AND CORRECT.

Signature: *Rich [Signature]*
(Transferor of Agent)

Telephone No.: (641) 765-4554

A tract of land located in the Southeast Quarter ($\frac{1}{4}$) of the Northeast Quarter ($\frac{1}{4}$) of Section Nine (9), Township Seventy-four (74) North, Range Twenty-six (26) West of the 5th P.M., Madison County, Iowa, containing 4.8512 acres, and more particularly described as follows, to-wit: Commencing at the East Quarter ($\frac{1}{4}$) Corner of said Section Nine (9), and being the point of beginning, thence North $00^{\circ}24'$ East 342.40 feet along the section line, thence South $84^{\circ}22'$ West 533.39 feet, thence South $02^{\circ}02'$ East 232.39 feet, thence South $85^{\circ}26'$ West 352.30 feet, thence South $00^{\circ}30'$ East 98.50 feet, thence North $85^{\circ}29'$ East 873.20 feet along the quarter Section line to the point of beginning. **AND** a tract of land located in the Northeast Quarter ($\frac{1}{4}$) of the Southeast Quarter ($\frac{1}{4}$) of said Section Nine (9), containing 14.3129, acres and more particularly described as follows, to-wit: Commencing at the East Quarter ($\frac{1}{4}$) Corner of said Section Nine (9), and being the point of beginning, thence South $85^{\circ}29'$ West 873.20 feet along the quarter Section line, thence South $00^{\circ}42'$ East 273.33 feet, thence North $88^{\circ}44'$ East 553.30 feet, thence South $00^{\circ}26'$ East 195.70 feet, thence South $86^{\circ}33'$ West 145.78 feet, thence South $44^{\circ}30'$ West 200.50 feet, thence South $11^{\circ}20'$ West 236.50 feet, thence South $69^{\circ}14'$ East 689.86 feet, thence North $00^{\circ}00'$ 1,153.80 feet along the section line to the point of beginning. NOTE: The east line of the Southeast Quarter ($\frac{1}{4}$) of said Section Nine (9) is assumed to bear due north and south.