

002971

FILED NO.

BOOK 3 PAGE 544

2000 FEB 10 PM 3:03


CHANELLE UTSLER
RECORDER
MADISON COUNTY, IOWA

*For Corrected Survey see
Farm Plat 3 Page 548
2-22-00*

REC \$ 5⁰⁰
AUD \$
R.M.F. \$ 1⁰⁰

COMPUTER ✓
RECORDED ✓
COMPARED ✓

BOLDMAN LAND SURVEYING P.C.
521 W. GREEN STREET
WINTERSSET, IA 50273

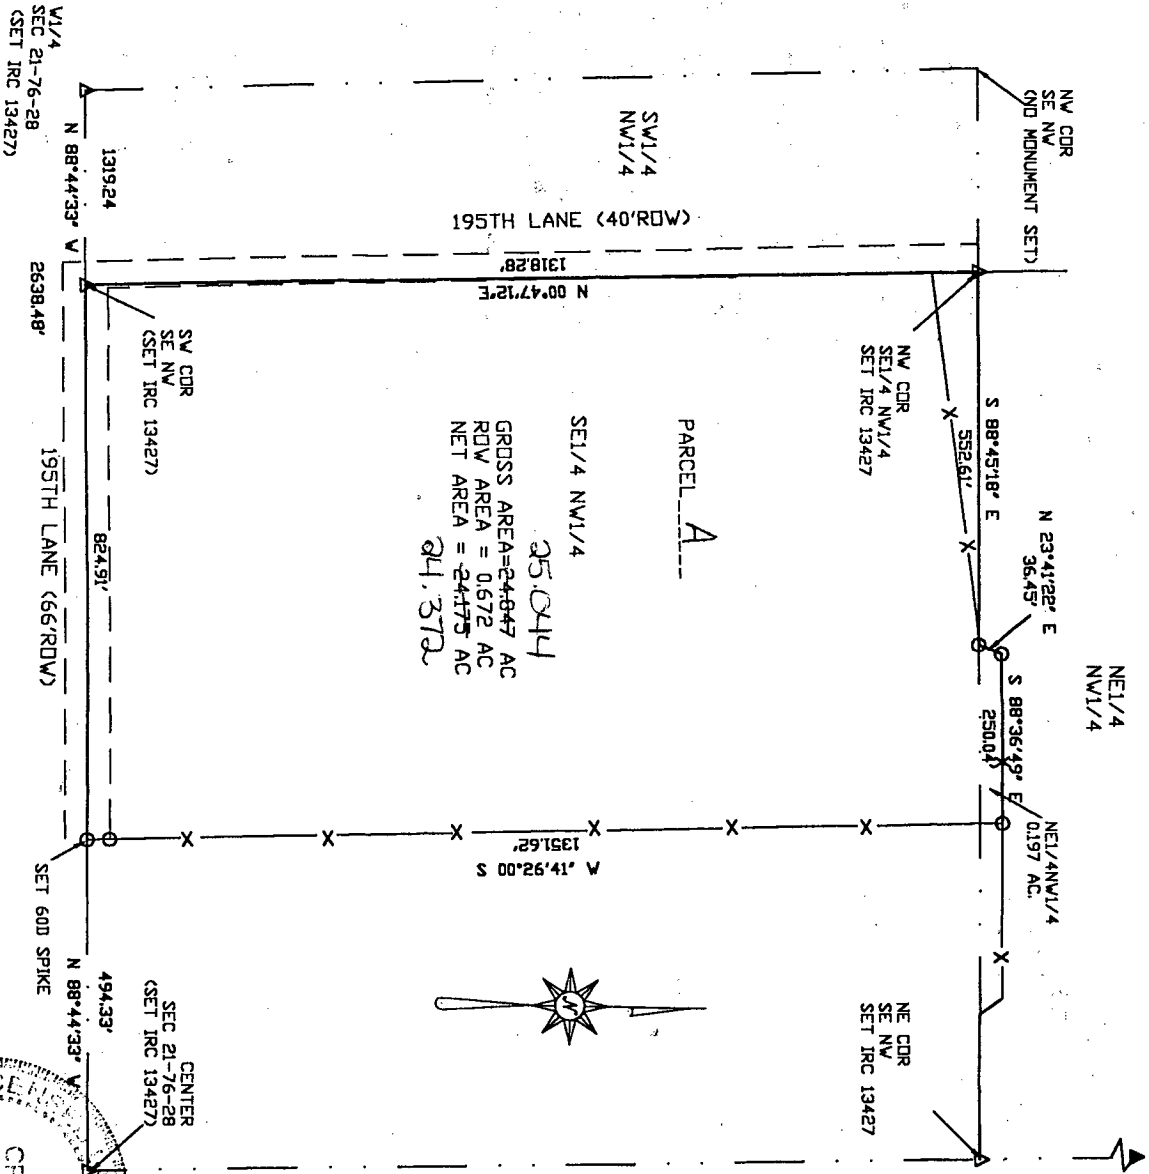

N1/4 COR
SEC 21-76-28
FOUND IRC 79953
NO EDGE OF STONES

PARCEL A PART OF THE SOUTHEAST QUARTER (SE1/4) OF THE NORTHWEST QUARTER (NW1/4) AND PART OF THE NORTHEAST QUARTER (NE1/4) OF THE NORTHWEST QUARTER (NW1/4) OF SECTION 21, TOWNSHIP 76 NORTH, RANGE 28 WEST OF THE 5TH P.M., MADISON COUNTY, IOWA DESCRIBED AS FOLLOWS:

BEGINNING AT THE SOUTHWEST CORNER OF SAID SE 1/4 NW1/4; THENCE N00°47'12"E, ALONG THE EAST LINE THEREOF, 1318.28 FEET TO THE NORTHWEST CORNER OF SAID SE1/4 NW1/4; THENCE S88°45'18"E, ALONG THE NORTHLINE THEREOF, 552.61 FEET; THENCE N23°41'22"E, ALONG AN EXISTING FENCE, 36.45 FEET; THENCE S88°45'18"E, ALONG THE NORTHLINE THEREOF, 552.61 FEET; THENCE N23°41'22"E, ALONG AN EXISTING FENCE, 36.45 FEET; THENCE S00°26'41"W, ALONG AN EXISTING FENCE, 1351.62 FEET TO A POINT ON THE SOUTH LINE OF SAID SE1/4 NW1/4; THENCE N88°44'33"W, ALONG SAID SOUTH LINE, 824.91 FEET TO THE POINT OF BEGINNING. SAID PARCEL CONTAINS 25.044 ACRES INCLUDING 0.672 ACRES OF COUNTY ROAD RIGHT OF WAY.

LEGEND


- ▲ FOUND SECTION OR ALIQUOT CORNER
- △ SET SECTION OR ALIQUOT CORNER
- monument set as noted
- monument found
- farm fence
- section line
- row easement
- property line

PLAT OF SURVEY

FIELD BOOK: 3	DRAWN BY: CSB
DATE: FEB 4, 2000	SCALE: 1"=200'
OWNER: MARK C. GROSSMAN	JOB NUMBER: 00-002

I HEREBY CERTIFY THAT THIS LAND SURVEYING DOCUMENT WAS PREPARED AND THE RELATED SURVEY WORK WAS PERFORMED BY ME OR UNDER MY DIRECT PERSONAL SUPERVISION AND THAT I AM A DULY LICENSED LAND SURVEYOR UNDER THE LAWS OF THE STATE OF IOWA.

SIGNATURE: *Craig S. Boldman*

NAME: CRAIG S. BOLDMAN
DATE: *2/10/00*
MY LICENSE RENEWAL DATE IS: DECEMBER 31, 2000

