
A PLAT OF A SURVEY MADE FOR MARCELLA A. FURRY IN THE WEST HALF OF THE NE¼ OF THE SE¼, TOWNSHIP 77 NORTH, RANGE 28 WEST OF THE 5TH P.M., MADISON COUNTY, IOWA

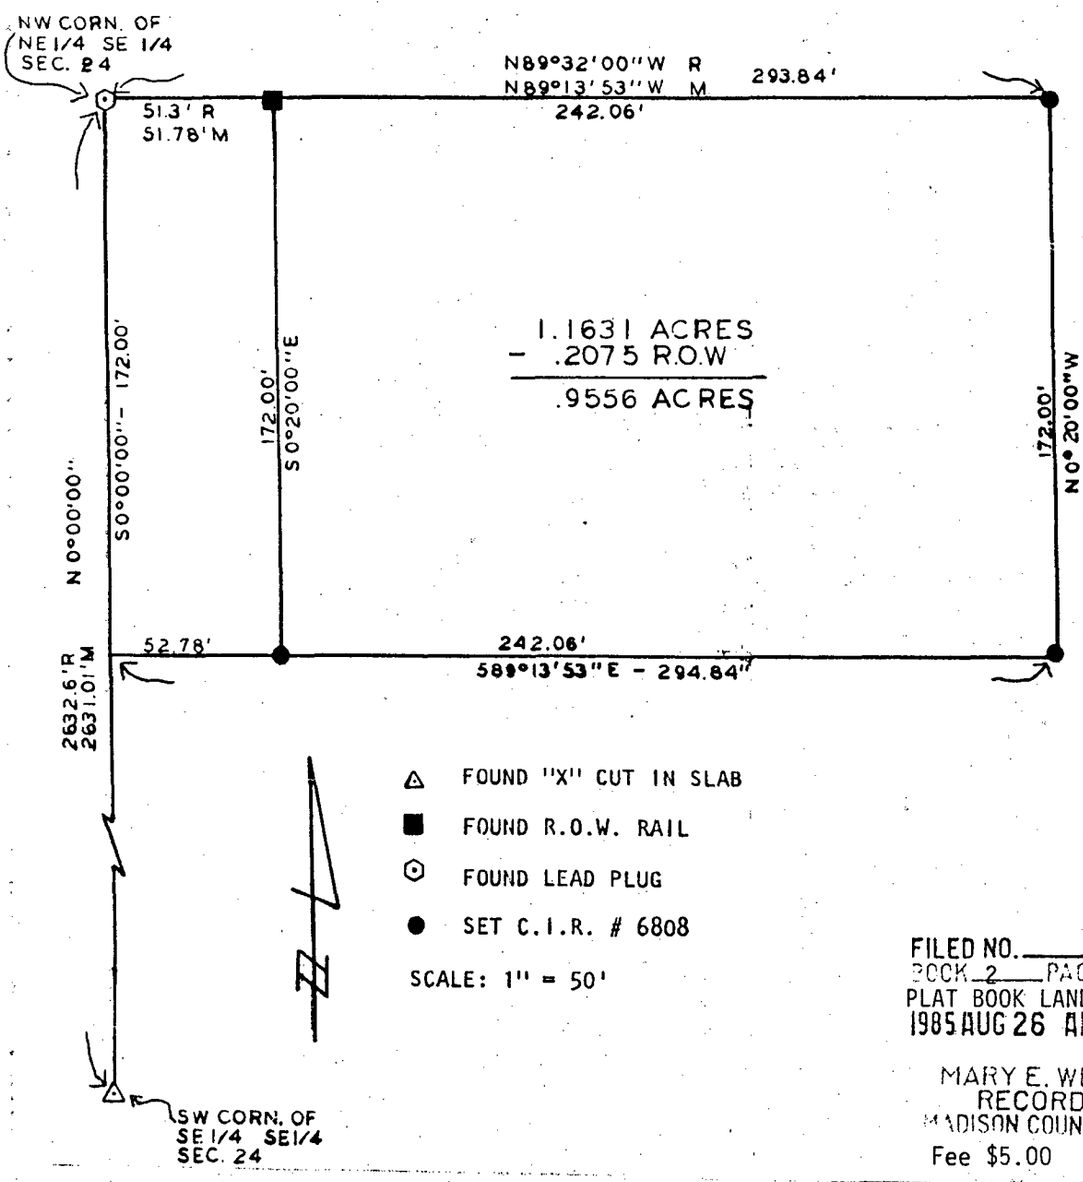

FILED NO. 384
BOOK 2 PAGE 6
PLAT BOOK LANDS
1985 AUG 26 AM 8:06

MARY E. WELTY
RECORDER
MADISON COUNTY, IOWA
Fee $5.00

DESCRIPTION:

A Parcel of Land described as beginning at the Northwest corner of the Northeast Quarter of the Southeast Quarter of Section 24, Township 77 North, Range 28 West of the 5th P.M., Madison County, Iowa; thence S0°00'00" 172.00' along the West line of the NE¼ of the SE¼ of said Section 24, thence S89°13'53"E 294.84, thence N0°20'00"W 172.00', thence N89°13'53"W 293.84' along the North line of the SE¼ of said Section 24 to the point of beginning, containing 1.1631 Acres, including .2075 Acres of Public Road Right of Way.

I HEREBY CERTIFY THAT THIS PLAN, SPECIFICATION, PLAT, MAP, SURVEY OR REPORT WAS MADE BY ME OR UNDER MY DIRECT PERSONAL SUPERVISION AND THAT I AM A DULY REGISTERED PROFESSIONAL ENGINEER AND LAND SURVEYOR UNDER THE LAWS OF THE STATE OF IOWA

SIGNED DATE

J. Jr. Hochstetler 8/15/85

J. Jr. Hochstetler P.E. & L.S. Iowa Reg. No. 6808

VANCE & HOCHSTETLER, P.C.
CONSULTING ENGINEERS
71 JEFFERSON STREET
WINTERSET, IOWA 50273