
STATE OF IOWA, MADISON COUNTY, ss.

Inst. No. 1316 Filed for Record this 27 day of December 19 85 at 3:20 PM

Book 2 Page 18 Recording Fee 5.00 Mary E. Welty, Recorder By M Welty Deputy

Farm Plat

Plat of a survey made for Thomas Walker
in the NE¼ of the NW¼ of Section 10, T75N, R26W
of the 5th P.M., Madison County, Iowa.

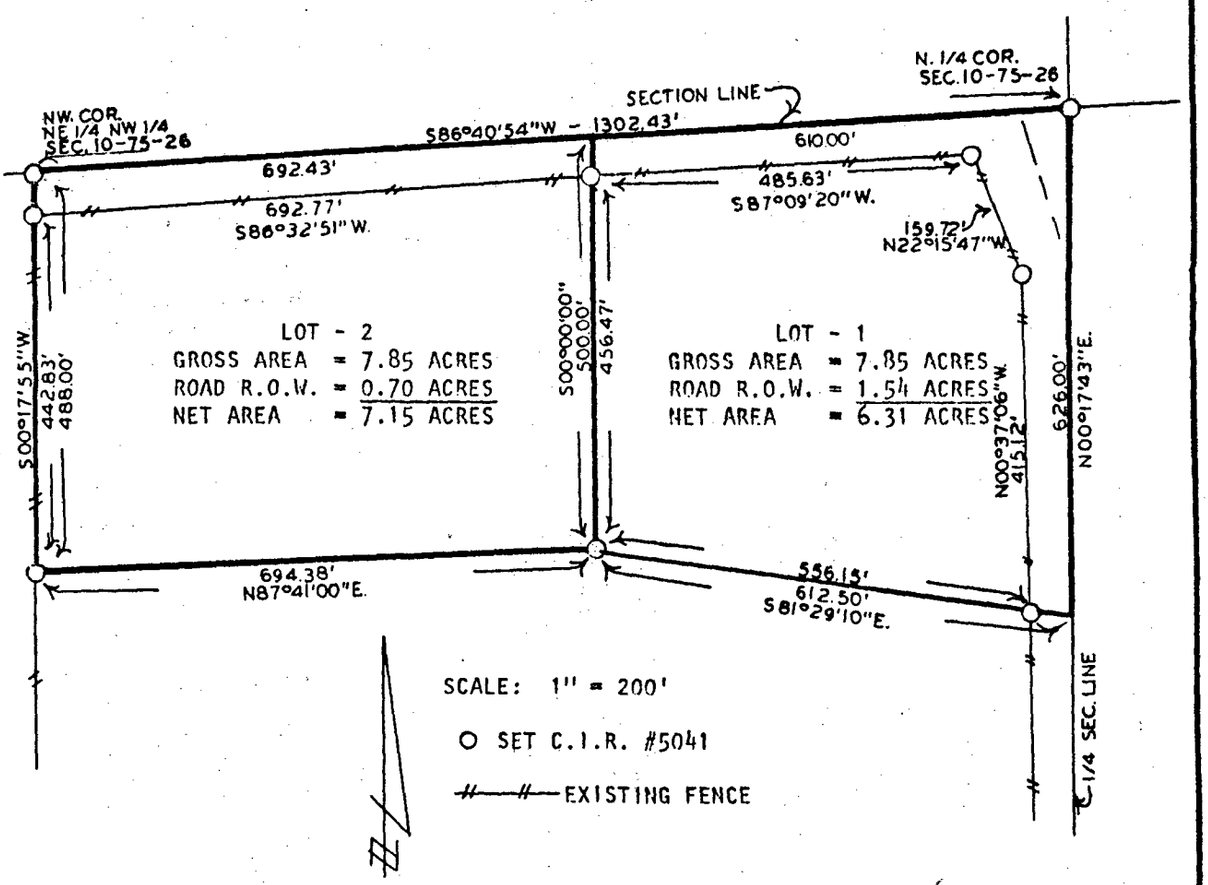

Description: Lot-1

A parcel of land in the Northeast Quarter of the Northwest Quarter of Section 10, Township 75 North, Range 26 West of the 5th Principal Meridian, Madison County, Iowa, more particularly described as follows:

Beginning at the North Quarter Corner (N.¼ Cor.) of Section 10, T75N, R26W of the 5th P.M., Madison County, Iowa; thence South 86°40'54" West 610.00 feet along the north line of the Northwest Quarter of said Sec. 10; thence South 00°00'00" 500.00 feet; thence South 81°29'10" East 612.50 feet to the east line of said Northwest Quarter; thence North 00°17'43" East 626.00 feet to the point of beginning. Said parcel contains 7.85 Acres including 1.54 Acres of County Road Right of Way.

Description: Lot-2

A parcel of land in the Northeast Quarter of the Northwest Quarter of Section 10, Township 75 North, Range 26 West of the 5th Principal Meridian, Madison County, Iowa, more particularly described as follows:

Commencing at the North Quarter Corner (N.¼ Cor.) of Section 10, T75N, R26W of the 5th P.M., Madison County, Iowa; thence South 86°40'54" West 610.00 feet along the north line of the Northwest Quarter of said Sec. 10 to the point of beginning. Thence continuing South 86°40'54" West 692.43 feet to the Northwest Corner of the NE.¼ of the NW.¼ of said Sec. 10; thence South 00°17'55" West 488.00 feet along the west line of said NE.¼ NW.¼; thence North 87°41'00" East 694.38 feet; thence North 00°00'00" 500.00 feet to the point of beginning. Said parcel contains 7.85 Acres including 0.70 Acres of County Road Right of Way.

I HEREBY CERTIFY THAT THIS PLAN, SPECIFICATION, PLAT, MAP, SURVEY OR REPORT WAS MADE BY ME OR UNDER MY DIRECT PERSONAL SUPERVISION AND THAT I AM A DULY REGISTERED PROFESSIONAL ENGINEER AND LAND SURVEYOR UNDER THE LAWS OF THE STATE OF IOWA

SIGNED Charles T. Vance DATE 27 Dec. 1985

Charles T. Vance, P.E. & L.S. Iowa Reg. No. 5041

VANCE & HOCHSTETLER, P.C.
CONSULTING ENGINEERS
71 JEFFERSON STREET
WINTERSET, IOWA 50273