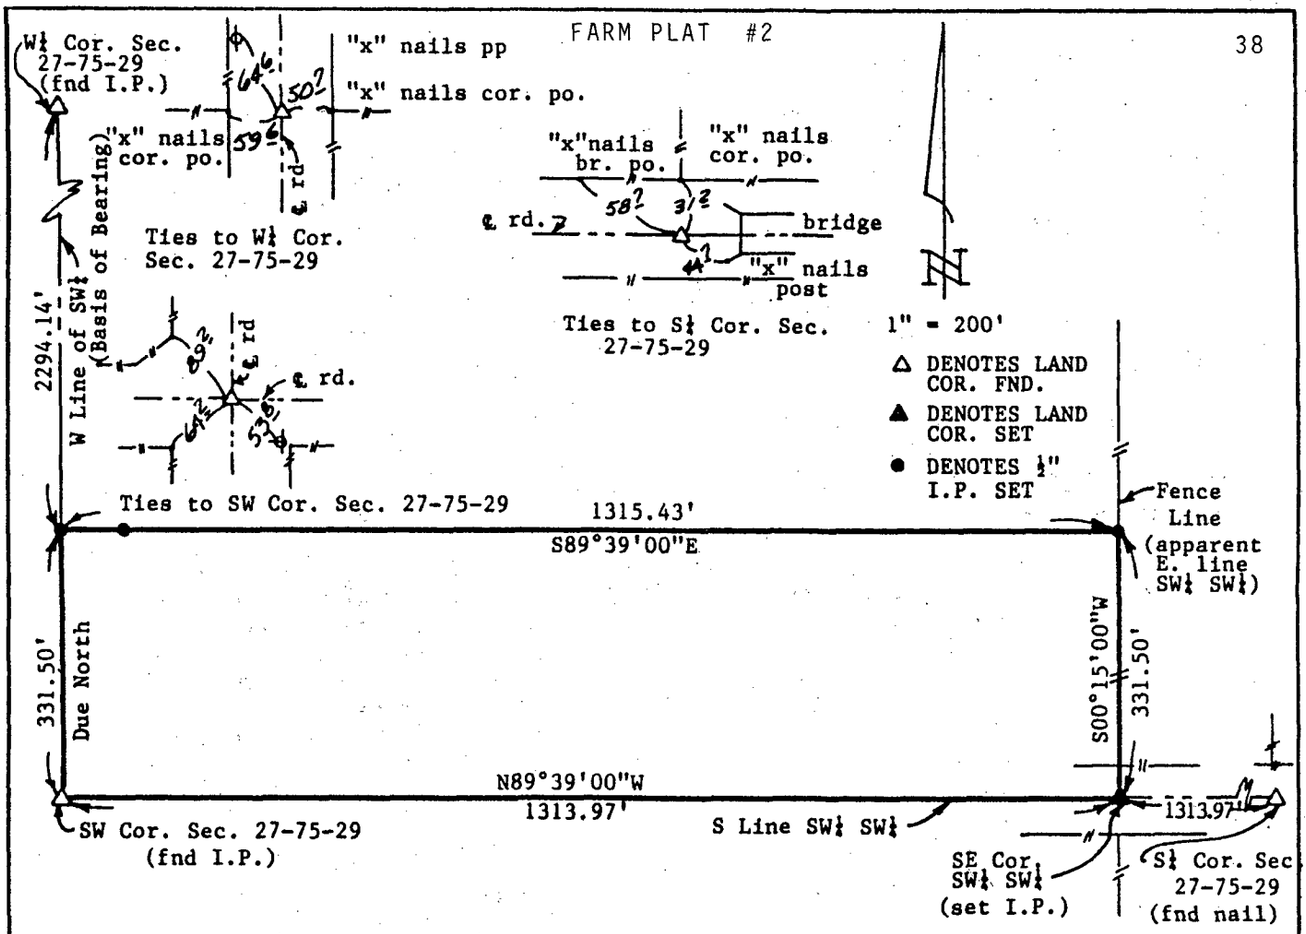


Description:

A tract of land in the SW¼ of the SW¼ of Section 27, Township 75 North, Range 29 West of the 5th P.M. in Madison County, Iowa more particularly described as;

Beginning at the SW corner of said Section 27, said point being the true point of beginning, thence due north along the west line of the SW ¼ of said Section 27, a distance of 331.50' to an iron pin, thence S89°39'00"E a distance of 1315.43' to an iron pin, said pin being on the apparent east line of the SW¼ of the SW¼ of said Section 27, thence S00°15'00"W along the apparent east line of the SW¼ of the SW¼ of said Section 27, a distance of 331.50' to an iron pin, said pin being the SE Corner of the SW¼ of the SW¼ of said Section 27, thence N89°39'00"W along the south line of the SW¼ of the SW¼ of said Section 27 a distance of 1313.97' to the true point of beginning, containing 10.00 acres subject to all recorded easements.

222
FILED NO.
BOOK 2 PAGE 38
FARM PLAT
1986 JUL 31 PM 2:52
MARY E. WELTY
RECORDER
MADISON COUNTY, IOWA
Fee $5.00

Subscribed and sworn to before me this 30th day of May, 19 86
Debbie Jimerson
Notary Public
(SEAL)

DEBBIE JIMERSON
MY COMMISSION EXPIRES
6-17-88

I hereby certify that this plat, map, survey or report was made by me or under my direct personal supervision and that I am a duly Registered Land Surveyor under the law of the state of Iowa.

John L Franklin
John L. Franklin, P.E. & L.S. Reg. No. 2760
Date 5-22-86

FRANKLIN 2760 IOWA PROF. ENGR. & LAND SURVEYOR

survey for PCA of the Midlands
P. O. Box 466
Creston, Iowa 50801
503760
date 5-22-86

MID-STATE ENGINEERING
Division of Howard R. Green Company
BOX 39
CRESTON, IOWA 50801

PRINTING 40-22 365/3