

FILED NO. 1834

BOOK 2 PAGE 2

98 OCT 30 AM 10:20

MICHELLE UTSLER
RECORDER
MADISON COUNTY, IOWA

REC \$ 5⁰⁰ COMPUTER
AUD \$ _____ RECORDED
P.M.F. \$ _____ COMPARED


Mer Engineering, Inc., 109 Regency West Court, Fort Dodge, Iowa Phone: 515-955-3635

UNITED STATES PUBLIC LAND SURVEY CORNER CERTIFICATE

Land Survey Monuments situated in Section 5, Township 74N,
Range 29W, of the Fifth Principal Meridian, MADISON
County, Iowa. Previously Recorded in _____ in County
Recorder's Office. (book, page, document number, etc.)


(Show reason for preparing this certificate, the evidence and detailed procedures used in est-
ablishing the corner positions and monumentation found or placed.)

Monument Description and Remarks: CORNERS FOUND AS SHOWN. USED
FOR BOUNDARY SURVEY IN SW 1/4 OF SAID SECTION 5.

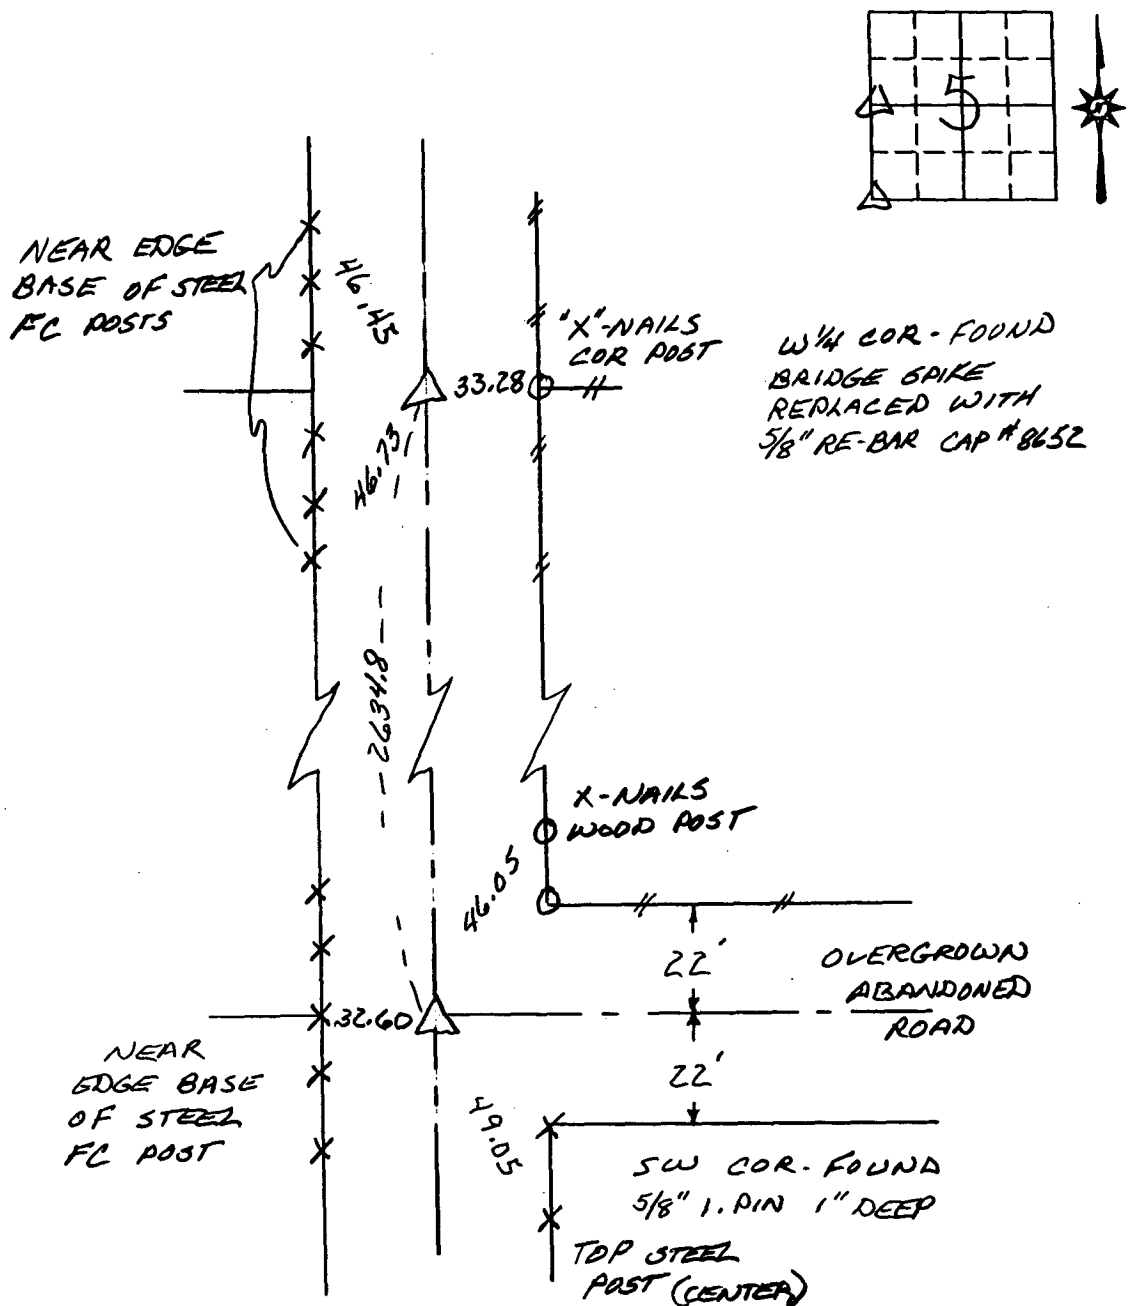

MER PROJECT # 10837

I HEREBY CERTIFY THAT THIS LAND SURVEYING DOCUMENT WAS PREPARED AND THE RELATED SURVEY WORK WAS PERFORMED BY ME OR UNDER MY DIRECT PERSONAL SUPERVISION AND THAT I AM A DULY LICENSED LAND SURVEYOR UNDER THE LAWS OF THE STATE OF IOWA.

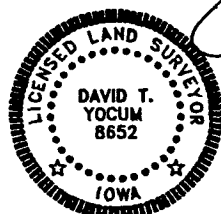

David T. Yocum
DAVID T. YOCUM (DATE) 10/27/98

LICENSE NUMBER 8652
MY LICENSE RENEWAL DATE IS DECEMBER 31, 1999

List Corners to be Indexed

Corners	Section	Twp	Range
W 1/4 COR	5	74N	29W
SW COR	5	74N	29W