983625

COMPUTER V
RECORDED V
COMPARED V

FILED NO. 3344
BOOK 2 PAGE 22
99 FEB 16 PM 3:50

REC $ 5.00
AUD $
R.M.F. $ 1.00

MICHELLE UTSLER
RECORDER
MADISON COUNTY, IOWA

VANCE & HOCHSTETLER, P.C., CONSULTING ENGINEERS, WINTERSET, IOWA (515) 462-3995
CHARLES T. VANCE, 110 West Green St., Winterset, Iowa, 50273
JAMES M HOCHSTETLER, 110 West Green St., Winterset, Iowa 50273

UNITED STATES PUBLIC LAND SURVEY CORNER CERTIFICATE

OF

Land Survey Monuments situated in Section 2, Township 77 North, Range 26 West, of the Fifth Principal Meridian, MADISON County, Iowa.
Previously recorded in _____ in County Recorder's Office.
(book, page, document number, etc.)

(Show reason for preparing this certificate, the evidence and detailed procedures used in establishing the the corner positions and monumentation found or placed.)

Monument Description and Remarks:


NW cor. SE.1/4 SE.1/4 - Set C.I.R. #6808 at existing fence corner.

SW cor. SE.1/4 SE.1/4 - Set C.I.R. #6808 in line with property line fence to North on line between SE cor. (found) and SW cor. SE.1/4 SW.1/4 (found).


PLAN - VIEW

(Show a minimum of three reference ties to durable physical objects, relevant monuments and physical conditions that will enable recovery of the corner.)

NW CORNER
SE.1/4 SE.1/4
SEC. 2-77-26
Set C.I.R.#6808

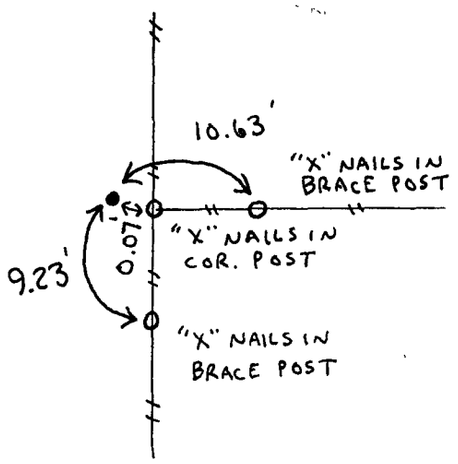

SW CORNER
SE.1/4 SE.1/4
SEC. 2-77-26
Set C.I.R.#6808

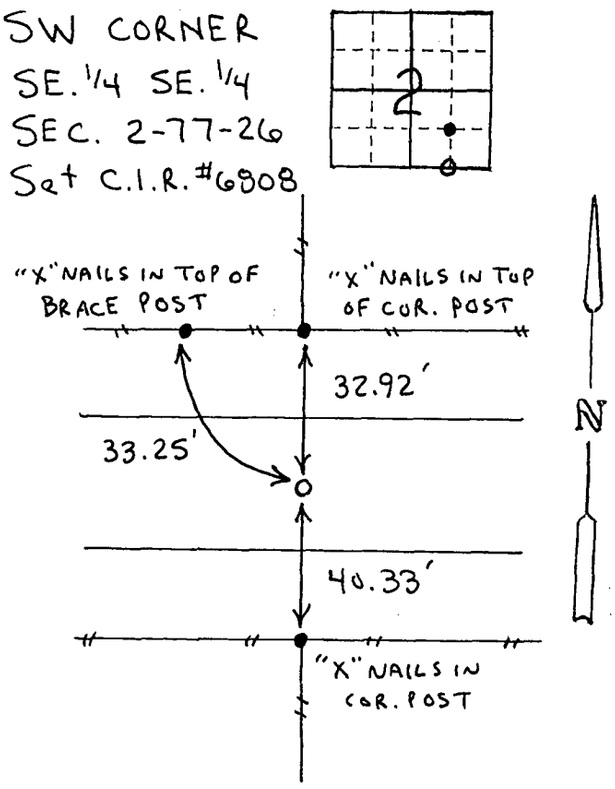

LICENSED LAND SURVEYOR
J.M. HOCHSTETLER
6808
IOWA

I hereby certify that this land surveying document was prepared and the related survey work was performed by me or under my direct personal supervision and that I am a duly licensed Land Surveyor under the laws of the State of Iowa.

J.M. Hochstetler
J.M. HOCHSTETLER
License number 6808 Date 2/12/99
My license renewal date is December 31, 99
Pages or sheets covered by this seal: 1

List Corners to be Indexed

Corners	Section	Twp	Range
NW cor. SE.1/4 SE.1/4	2	77N	26W
SW cor. SE.1/4 SE.1/4	2	77N	26W