

REC \$ 5⁰⁰ COMPUTER
 AUD \$ _____ RECORDED
 R.M.F. \$ 1⁰⁰ COMPARED

FILED NO. 4659
 BOOK 2 PAGE 44
 99 MAY 17 PM 1:29

PREPARED BY: BOLDMAN LAND SURVEYING, P.C. 521 WEST GREEN STREET, WINTERSSET, IA 50273. PHONE: (515) 462-3308

UNITED STATES PUBLIC LAND SURVEY CORNER CERTIFICATE
 OF

Land Survey Monuments situated in Section 16, Township 74, Range 28 of the Fifth Principal Meridian, MADISON County, Iowa
 Previously recorded in CORRECTS CERTIFICATE FILED BOOK 2 PAGE 40 in County Recorder's Office.
 (book, page, document number, etc.)



(show reason for preparing this certificate, the evidence and detailed procedures used in establishing the corner positions and monumentation found or placed.)

Monument Description and Remarks: ① ACCEPTED CORNER POST AT INTERSECTION OF ANCIENT FENCES FOR S1/4 COR. MEASURED DISTANCE ACROSS SOUTH LINE SE 1/4 TO A CORNER POST REASONABLY FITS THE GOVERNMENT RECORD.
 ② SET 1/2" PIN LS#13427 IN CENTERLINE OF ROAD IN LINE WITH FENCE SOUTH FOR NE CORNER SW1/4.
 FOR NE COR E1/2 SW1/4. ③ SET 1/2" PIN LS#13427 AT INTERSECTION OF ROAD TANGENTS FOR NW COR E1/2 SW 1/4.


PLAN-VIEW

(Show a minimum of three reference ties to durable physical objects, relevant monuments and physical conditions that will enable recovery of the corner.)


① ALL "X" NAILS IN FENCE POSTS

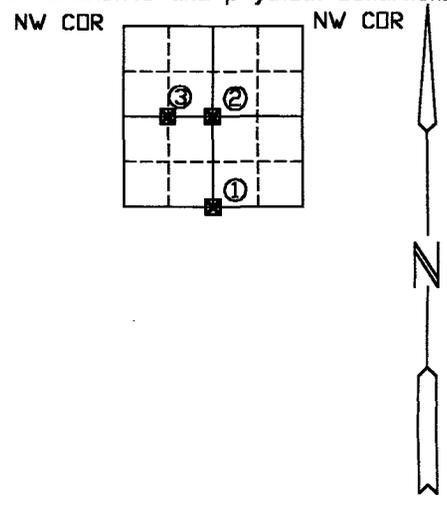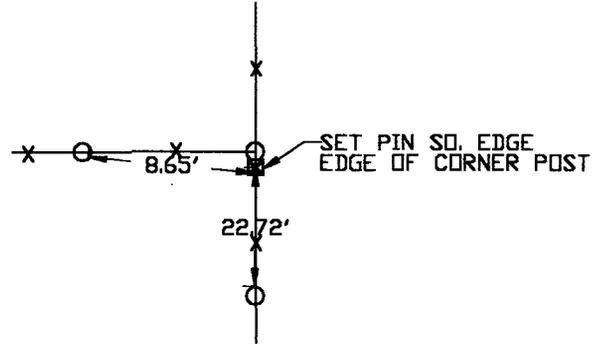

② ALL "X" NAILS

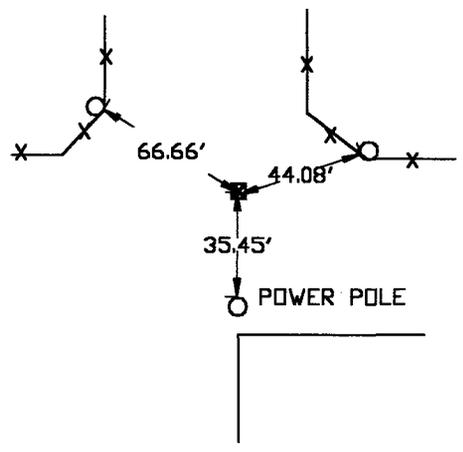


③ ALL "X" NAILS IN FENCE POSTS

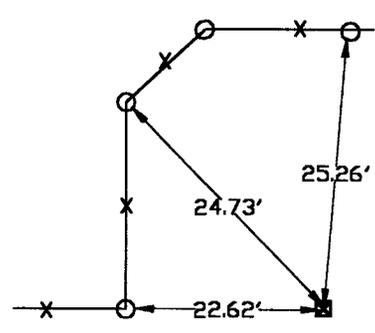

I hereby certify that the survey work was completed and this certificate was prepared by me or under my direct personal supervision and that I am a duly Licensed Land Surveyor under the laws of the State of Iowa

Signature: Craig S. Boldman
 Date: 5/17/99 Reg. No. 13427

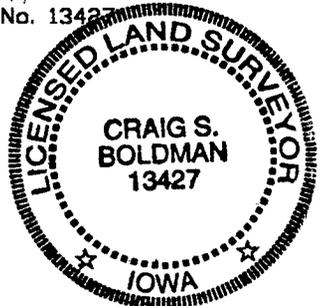

SEAL

List Corners to be Indexed

Corners	Section	Twp	Range
S1/4	16	74	28
NE CORNER E1/2 SW 1/4	16	74	28
NW CORNER E1/2 SW 1/4	16	74	28