FILED NO. 000620

BOOK 2 PAGE 86

99 AUG 10 AM 10: 51

MICHELLE UTSLER
RECORDER
MADISON COUNTY, IOWA

COMPUTER ✓
RECORDED ✓
COMPARED ✓

REC $ 5.00
AUD $
R.M.F. $ 1.00

VANCE & HOCHSTETLER, P.C., CONSULTING ENGINEERS, WINTERSET, IOWA (515) 462-3995
CHARLES T. VANCE, 110 West Green St., Winterset, Iowa, 50273
JAMES M HOCHSTETLER, 110 West Green St., Winterset, Iowa 50273

UNITED STATES PUBLIC LAND SURVEY CORNER CERTIFICATE

OF

Land Survey Monuments situated in Section 27, Township 77N, Range 29W, of the Fifth Principal Meridian, MADISON County, Iowa.

Previously recorded in _____ in County Recorder's Office.
(book, page, document number, etc.)

(Show reason for preparing this certificate, the evidence and detailed procedures used in establishing the the corner positions and monumentation found or placed.)


Monument Description and Remarks: E¼ COR. - Set CIR # 6808 in center of County Road R.O.W. Fences in line with old Property line fences East and West. Point was within one foot of distance split between found N.E. & S.E. Corners of Section.

N.E COR - Found ½" Iron Rod from ties in County Engineer's records


PLAN - VIEW


(Show a minimum of three reference ties to durable physical objects, relevant monuments and physical conditions that will enable recovery of the corner.)

EAST QUARTER CORNER
SEC. 27-77-29
SET CIR # 6808 - 2" Deep

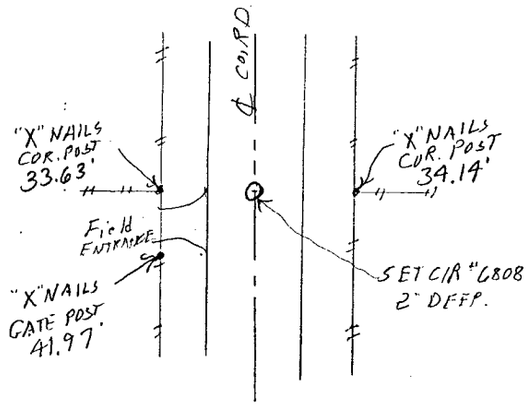

N.E. COR.
SEC 27-77-29
FOUND ½" IRON ROD
6" DEEP.

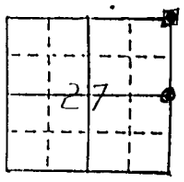

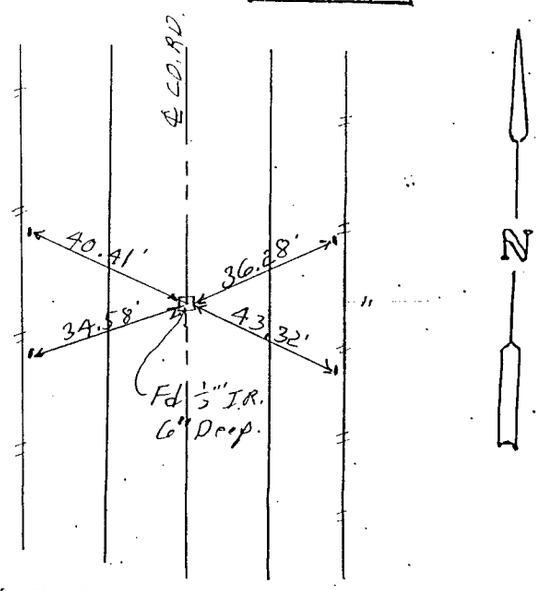

ALL TIES TO "X" IN TOP OF GRADER BLADE WITH STEEL POST.

LICENSED LAND SURVEYOR
J. M. HOCHSTETLER
6808
IOWA

I hereby certify that this land surveying document was prepared and the related survey work was performed by me or under my direct personal supervision and that I am a duly licensed Land Surveyor under the laws of the State of Iowa.

J. M. Hochstetler

J. M. HOCHSTETLER

License number 6808 Date 8/9/99

My license renewal date is December 31, 1999.

Pages or sheets covered by this seal: 1

List Corners to be Indexed

Corners	Section	Twp	Range
E ¼ COR	27	77	29
NE COR	27	77	29