

COMPUTER ☒
RECORDED ☒
COMPALED ☒

1999 OCT 27 PM 1:46
MICHELLE UTSLER
RECORDER
MADISON COUNTY, IOWA

VANCE & HOCHSTETLER, P.C., CONSULTING ENGINEERS, WINTERSSET, IOWA (515) 462-3995
CHARLES T. VANCE, 110 West Green St., Winterset, Iowa, 50273
JAMES M HOCHSTETLER, 110 West Green St., Winterset, Iowa 50273

UNITED STATES PUBLIC LAND SURVEY CORNER CERTIFICATE

OF
Land Survey Monuments situated in Section 1, Township 75 N, Range 29 W
of the Fifth Principal Meridian, MADISON County, Iowa.
Previously recorded in _____ in County Recorder's Office.
(book, page, document number, etc.)


(Show reason for preparing this certificate, the evidence and detailed procedures used in establishing the the corner positions and monumentation found or placed.)

Monument Description and Remarks: SE COR SEC. 1 - Set 1/2" rebar with yellow cap
#6808 at Intersection of Property Line fences from N., S., E., & W.
E 1/4 Cor. Sec. 1 - Set 1/2" rebar with yellow cap in line with property
line fences from S., E., & W.
S.W. COR. SE 1/4 SE 1/4 - Co. Engr. Records show stone found and Iron Pin set
over in 1951. Found old "X" Nails ties and found nail at intersect of ties
but could not find Iron Pin or stone - Set 1/2" rebar with yellow Cap #6808 at found nail.



PLAN - VIEW

(Show a minimum of three reference ties to durable physical objects, relevant monuments and physical conditions that will enable recovery of the corner.)


SE COR. SEC. 1 - 75-29
SET 1/2" Rebar W/Yellow Cap # 6808

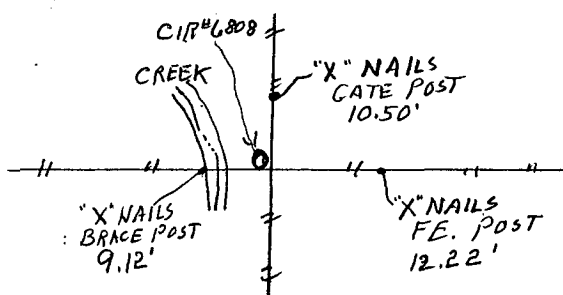

E 1/4 COR.
SEC. 1 - 75-29
SET 1/2" Rebar
W/Yellow Cap #6808

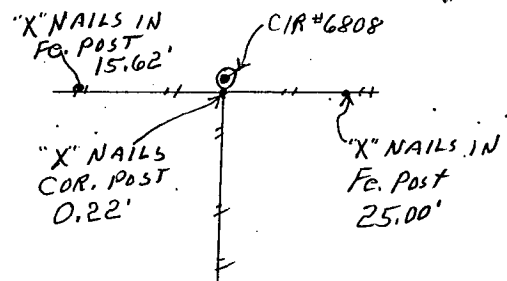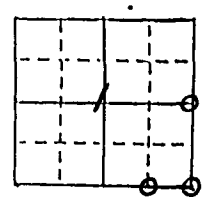


SW COR, SE 1/4 SE 1/4
1-75-29
SET 1/2" Rebar
W/Yellow Cap #6808

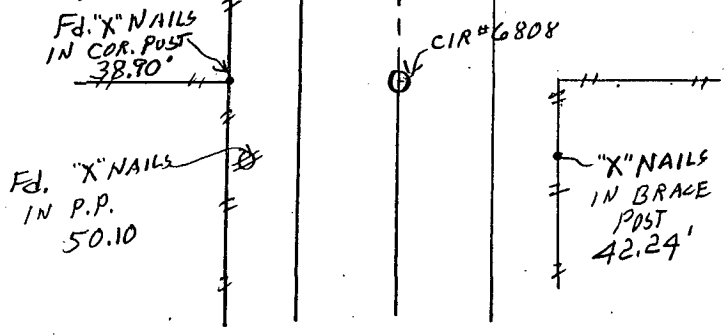

List Corners to be Indexed

Corners	Section	Twp	Range
SE COR.	1	75N	29W
E 1/4 COR.	1	75N	29W
SW COR. SE 1/4 SE 1/4	1	75N	29W

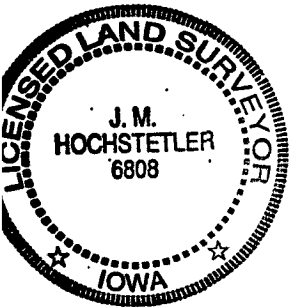

I hereby certify that this land surveying document was prepared and the related survey work was performed by me or under my direct personal supervision and that I am a duly licensed Land Surveyor under the laws of the State of Iowa.

J.M. Hochstetler
J.M. HOCHSTETLER
License number 6808 Date 10/22/99
My license renewal date is December 31, 1999.
Pages or sheets covered by this seal: 1