

REC \$ 5⁰⁰
 AUD \$ _____
 R.M.F. \$ 1⁰⁰

FILED NO. 001843
 BOOK 2 PAGE 102
 1999 NOV -5 AM 10: 09

COMPUTER
 RECORDED
 COMPARED

PREPARED BY: BOLDMAN LAND SURVEYING, P.C. 521 WEST GREEN STREET, WINTERSET, IA 50273 PH: (515) 462-9242
 JANELLE UTSLER
 RECORDER
 MADISON COUNTY, IOWA

UNITED STATES PUBLIC LAND SURVEY CORNER CERTIFICATE

OF


Land Survey Monuments situated in Section 2, Township 75 N, Range 29 W, of the Fifth Principal Meridian, Madison County, Iowa
 Previously recorded in None in County Recorder's Office.
 (book, page, document number, etc.)

(show reason for preparing this certificate, the evidence and detailed procedures used in establishing the corner positions and monumentation found or placed.)

Monument Description and Remarks: Set 5/8" capped rebar in line with fences at split of R.O.W. Co. Engineer records indicates a conc. fence post "east" of section corner.

PLAN-VIEW

(Show a minimum of three reference ties to durable physical objects, relevant monuments and physical conditions that will enable recovery of the corner.)

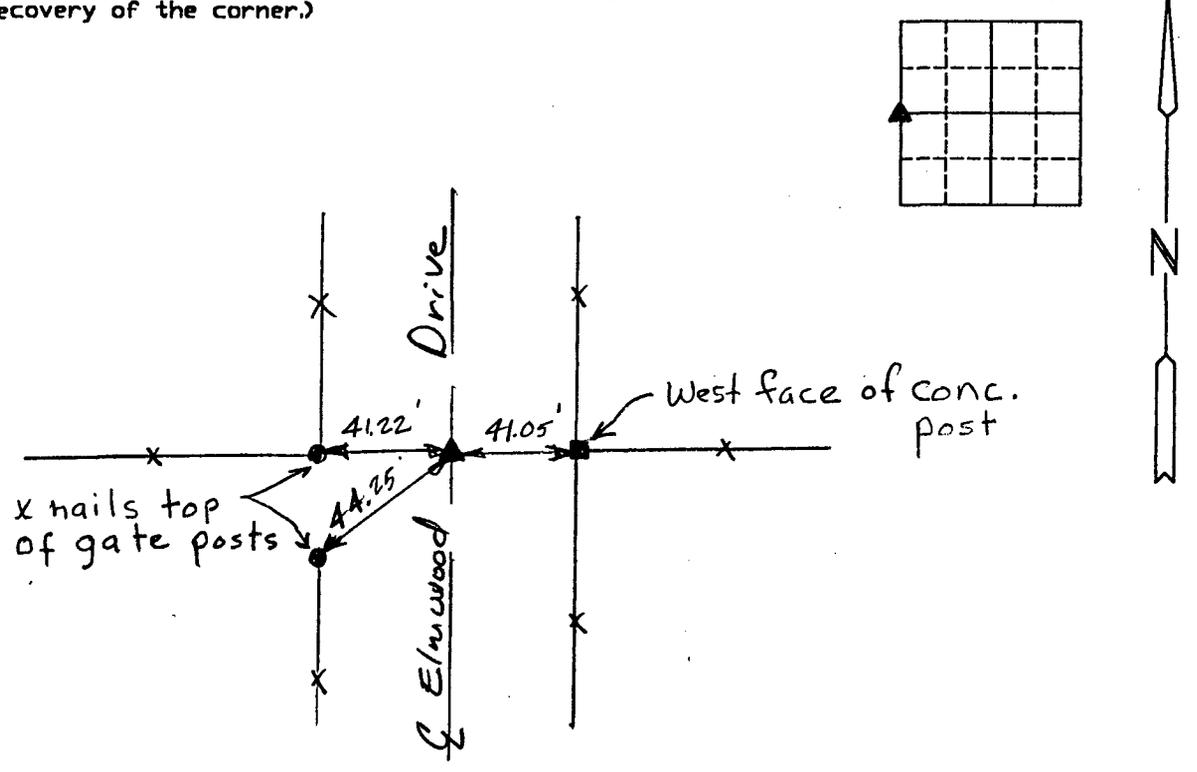

Ref. to West 1/4 Corner

I hereby certify that the survey work was completed and this certificate was prepared by me or under my direct personal supervision and that I am a duly Licensed Land Surveyor under the laws of the State of Iowa

Signature: Craig S. Boldman
 Craig S. Boldman

Date: 11-5-99 Reg. No. 13427

List Corners to be Indexed

Corners	Section	Twp	Range
W 1/4	2	75	29

SEAL

