REC $ 5.00
AUD $
R.M.F. $ 1.00
COMPUTER ✓
RECORDED ✓
COMPARED ✓

FILED NO. 002343
BOOK 2 PAGE 123
1999 DEC 21 PM 3:33
[illegible] UTSLER
RECORDER
MADISON COUNTY, IOWA

VANCE & HOCHSTETLER, P.C., CONSULTING ENGINEERS, WINTERSET, IOWA (515) 462-3995
CHARLES T. VANCE, 110 West Green St., Winterset, Iowa, 50273
JAMES M HOCHSTETLER, 110 West Green St., Winterset, Iowa 50273

UNITED STATES PUBLIC LAND SURVEY CORNER CERTIFICATE

OF

Land Survey Monuments situated in Section 30, Township 74 NORTH, Range 26 WEST, of the Fifth Principal Meridian, MADISON County, Iowa.
Previously recorded in _____ in County Recorder's Office.
(book, page, document number, etc.)

(Show reason for preparing this certificate, the evidence and detailed procedures used in establishing the the corner positions and monumentation found or placed.)

Monument Description and Remarks:


E. 1/4 cor. - Set Capped Iron Rod (C.I.R.) #6808, 4" deep, in line with E-W property line fence on line projected from SE cor. & SE cor. NE. 1/4 SE. 1/4 (both found).

NW cor. NE. 1/4 SE. 1/4 - Set C.I.R. #6808, exposed, at existing fence corner.


PLAN - VIEW


(Show a minimum of three reference ties to durable physical objects, relevant monuments and physical conditions that will enable recovery of the corner.)

EAST 1/4 COR.
SEC. 30-74-26
Set C.I.R. #6808

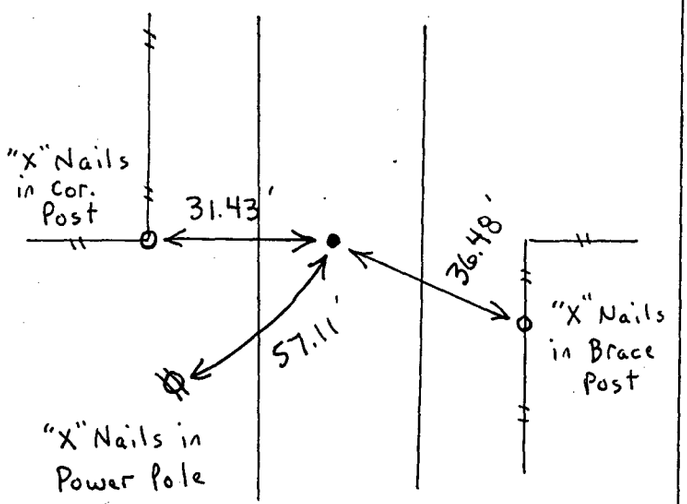

NW CORNER
NE. 1/4 SE. 1/4
SEC. 30-74-26
Set C.I.R. #6808

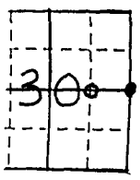

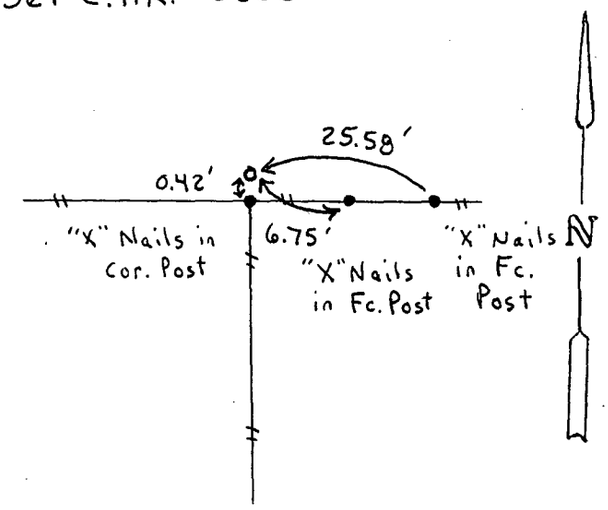

I hereby certify that this land surveying document was prepared and the related survey work was performed by me or under my direct personal supervision and that I am a duly licensed Land Surveyor under the laws of the State of Iowa.

J. M. HOCHSTETLER

License number 6808 Date 12/14/99

My license renewal date is December 31, 1999.

Pages or sheets covered by this seal: 1

LICENSED LAND SURVEYOR
J. M. HOCHSTETLER
6808
IOWA

List Corners to be Indexed

Corners	Section	Twp	Range
E. 1/4 cor.	30	74N	26W
NW cor. NE. 1/4 SE. 1/4	30	74N	26W