

COMPUTER ✓  
RECORDED ✓  
COMPARED ✓

FILED NO. 002207

BOOK 2 PAGE 119

1999 DEC -8 PM 3:55

REC \$ 5.00

AUD \$ 00

R.M.F. \$ 00

MICHELLE UTSLER  
RECORDER  
MADISON COUNTY, IOWA

VANCE & HOCHSTETLER, P.C., CONSULTING ENGINEERS, WINTERSET, IOWA (515) 462-3995  
CHARLES T. VANCE, 110 West Green St., Winterset, Iowa, 50273  
JAMES M HOCHSTETLER, 110 West Green St., Winterset, Iowa 50273

UNITED STATES PUBLIC LAND SURVEY CORNER CERTIFICATE

OF  
Land Survey Monuments situated in Section 36, Township 76 NORTH, Range  
26 WEST, of the Fifth Principal Meridian, MADISON County, Iowa.  
Previously recorded in \_\_\_\_\_ in County Recorder's Office.  
(book, page, document number, etc.)

(Show reason for preparing this certificate, the evidence and detailed procedures used in establishing the the corner positions and monumentation found or placed.)



Monument Description and Remarks:

NE cor. SW. 1/4 SW. 1/4 - Set capped Iron Rod (C.I.R.) #6808 using  
the NW cor. SW. 1/4 SW. 1/4 and the NE cor. SE. 1/4 SW. 1/4 (both  
found corners) and survey points found along the North  
line of the SW. 1/4 SW. 1/4

PLAN - VIEW

(Show a minimum of three reference ties to durable physical objects, relevant monuments and physical conditions that will enable recovery of the corner.)

NE CORNER  
SW. 1/4 SW. 1/4  
SEC. 36-76-26  
Set C.I.R. #6808

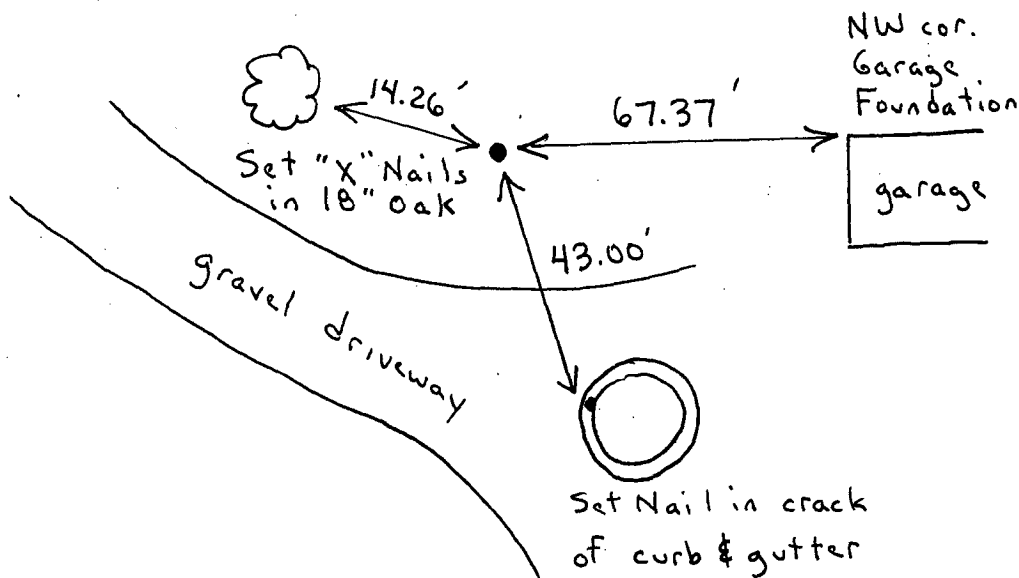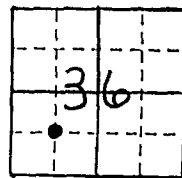

List Corners to be Indexed

Corners	Section	Twp	Range
NE cor.	36	76N	26W
SW. 1/4 SW. 1/4			

I hereby certify that this land surveying document was prepared and the related survey work was performed by me or under my direct personal supervision and that I am a duly licensed Land Surveyor under the laws of the State of Iowa.

J. M. Hochstetler  
J. M. HOCHSTETLER

License number 6808 Date 12/8/99

My license renewal date is December 31, 1999.

Pages or sheets covered by this seal: 1

