

REC \$ 5.00

AUD \$

R.M.F. \$ 1.00

COMPUTER

RECORDED

COMPARED

BOOK 2 PAGE 132

2000 MAR -2 PM 3: 19

MICHELLE UTSLER  
RECORDER  
MADISON COUNTY, IOWA

VANCE & HOCHSTETLER, P.C., CONSULTING ENGINEERS, WINTERSSET, IOWA (515) 462-3995  
CHARLES T. VANCE, 110 West Green St., Winterset, Iowa, 50273  
JAMES M HOCHSTETLER, 110 West Green St., Winterset, Iowa 50273

UNITED STATES PUBLIC LAND SURVEY CORNER CERTIFICATE



OF  
Land Survey Monuments situated in Section 24, Township 75 N, Range 26 W, of the Fifth Principal Meridian, MADISON County, Iowa.  
Previously recorded in SECTION CORNER CERTIFICATE BOOK 1 PAGE 153 in County Recorder's Office.  
(book, page, document number, etc.)

(Show reason for preparing this certificate, the evidence and detailed procedures used in establishing the the corner positions and monumentation found or placed.)

Monument Description and Remarks: EVIDENTLY THE 1" PIPE FOUND AND TIED BY DAVID M. HILLER IN 1993 WAS DESTROYED DURING CONCRETE PAVING OF A PARKING LOT. WE CUT AN "X" IN CONCRETE FROM HILLER'S TIES.

PLAN - VIEW

(Show a minimum of three reference ties to durable physical objects, relevant monuments and physical conditions that will enable recovery of the corner.)

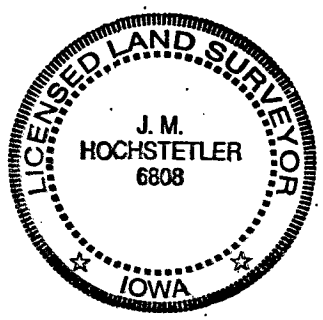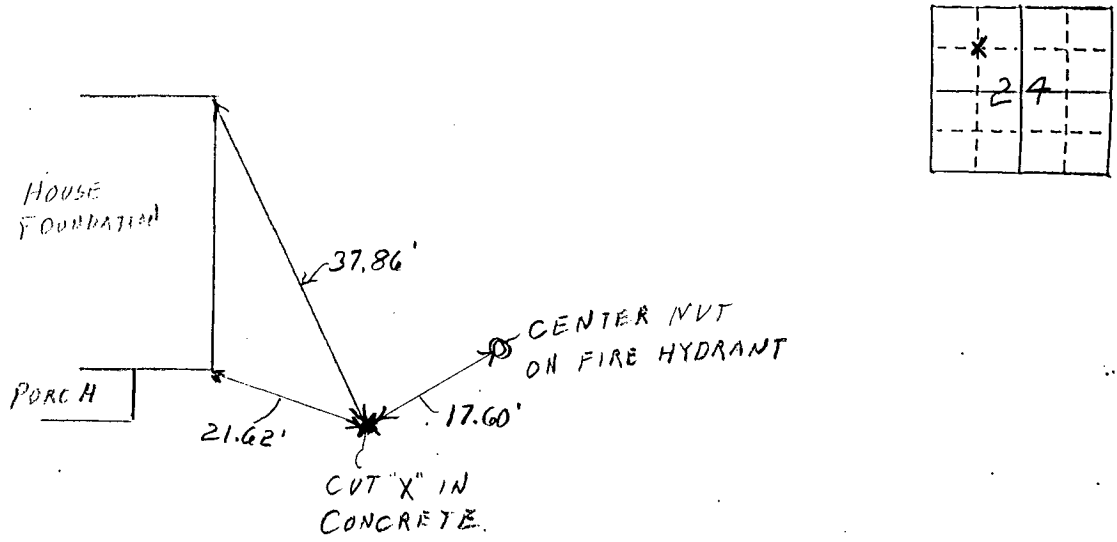

I hereby certify that this land surveying document was prepared and the related survey work was performed by me or under my direct personal supervision and that I am a duly licensed Land Surveyor under the laws of the State of Iowa.

J.M. Hochstetler  
J.M. HOCHSTETLER  
License number 6808 Date 11/4/2000  
My license renewal date is December 31, 2001.  
Pages or sheets covered by this seal: 1

List Corners to be Indexed

Corners	Section	Twp	Range
SW COR NE 1/4 NW 1/4	24	75N	26W