2000-345

FILED NO. 003220

BOOK 2 PAGE 134

REC $ 5.00
AUD $
R.M.F. $ 1.00

COMPUTER ✓
RECORDED ✓
COMPARED ✓

2000 MAR -2 PM 3:21

MICHELLE UTSLER
RECORDER
MADISON COUNTY, IOWA

J

VANCE & HOCHSTETLER, P.C., CONSULTING ENGINEERS, WINTERSET, IOWA (515) 462-3995
CHARLES T. VANCE, 110 West Green St., Winterset, Iowa, 50273
JAMES M HOCHSTETLER, 110 West Green St., Winterset, Iowa 50273

UNITED STATES PUBLIC LAND SURVEY CORNER CERTIFICATE

OF

Land Survey Monuments situated in Section 18, Township 75 NORTH, Range 29 WEST, of the Fifth Principal Meridian, MADISON County, Iowa.

Previously recorded in _____ in County Recorder's Office.
(book, page, document number, etc.)

(Show reason for preparing this certificate, the evidence and detailed procedures used in establishing the the corner positions and monumentation found or placed.)


Monument Description and Remarks:

- SW cor. - Set Capped Iron Rod #6808 (½" rebar, 3" deep) at split between the NW cor. SW.¼ SW.¼ Sec. 18, and the SE cor. NE.¼ NE.¼ Sec. 19 on line projection from W.¼ cor. using road R.O.W. split at this point.
- NW cor. SW.¼ SW.¼ - Set Capped Iron Rod #6808 (½" rebar, 3" deep) in line with an E.-W. property line fence on line between SW cor. & W.¼ cor. (already referenced).


PLAN - VIEW


(Show a minimum of three reference ties to durable physical objects, relevant monuments and physical conditions that will enable recovery of the corner.)

SW CORNER
SEC. 18-75-29
Set C.I.R. #6808

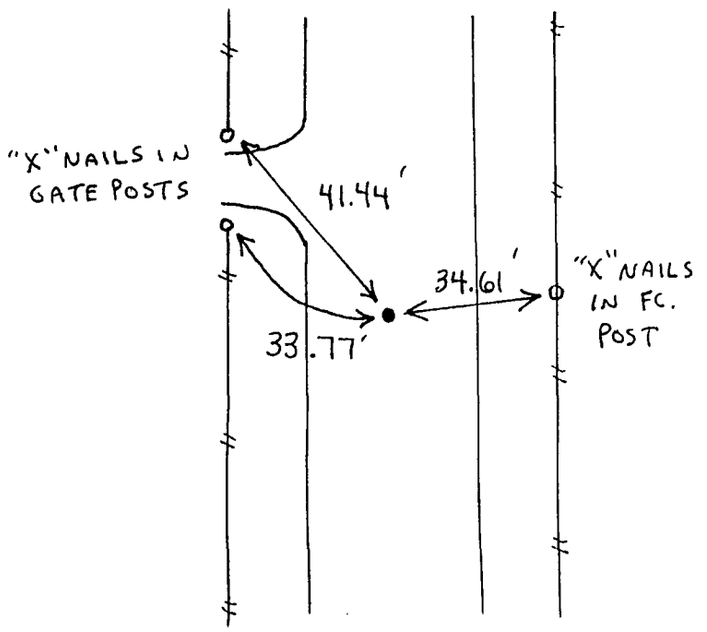

NW CORNER
SW.¼ SW.¼
SEC 18-75-29
Set C.I.R. #6808

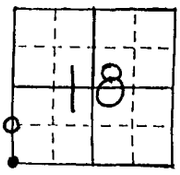

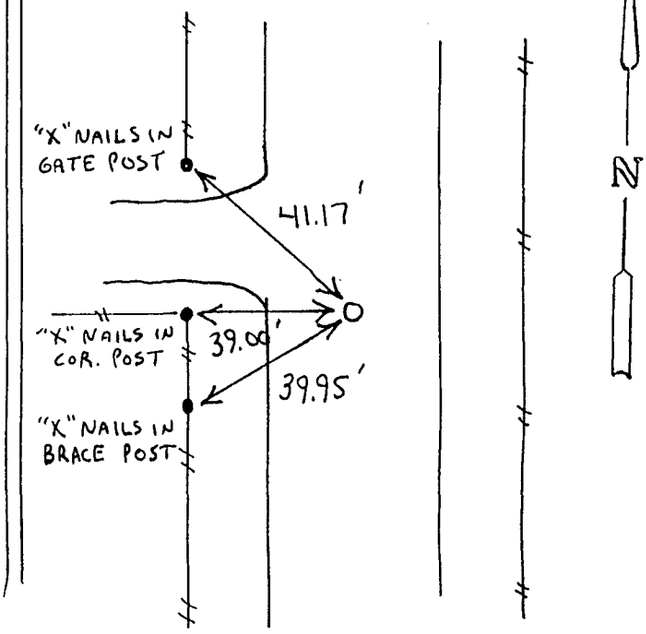

LICENSED LAND SURVEYOR
J. M. HOCHSTETLER
6808
IOWA

I hereby certify that this land surveying document was prepared and the related survey work was performed by me or under my direct personal supervision and that I am a duly licensed Land Surveyor under the laws of the State of Iowa.

J. M. Hochstetler
J. M. HOCHSTETLER

License number 6808 Date 3/2/2000

My license renewal date is December 31 2001.

Pages or sheets covered by this seal: 1

List Corners to be Indexed

Corners	Section	Twp	Range
SW cor.	18	75N	29 W
NW cor. SW.¼ SW.¼	18	75N	29 W