

REC \$ 5.00
AUD \$
R.M.F. \$ 1.00

COMPUTER
RECORDED
COMPARED

FILED NO. 003277
BOOK 2 PAGE 135
2000 MAR -7 PM 3:18

MICHELLE UTSLER
RECORDER
MADISON COUNTY, IOWA

Prepared By: J. Brian Morrissey, Morrissey Surveying, 1405 Hwy. G28, Otley, Iowa 50214-8518, 515-627-5554

UNITED STATES PUBLIC LAND SURVEY CORNER CERTIFICATE OF



Land Survey Monuments situated in Section 11, Township 74 N., Range 26 W, of the Fifth Principal Meridian, Madison County, Iowa.
Previously recorded in N.A. in County Recorders Office.
(book, page, document number, etc.)

(Show reason for preparing this certificate, the evidence and detailed procedures used in establishing the corner positions and monumentation found or placed.)

Monument Description and Remarks: Set P.K. nail in pavement at intersection of line from West Quarter Corner to East Quarter Corner and fence line to the South. Postion checked reasonably close to IDOT right of way acquisition strip map for former Ia. Hwy. 400.

PLAN VIEW

(Show a minimum of three reference ties to durable physical objects, relevant monuments and physical conditions that will enable recovery of the corner.)

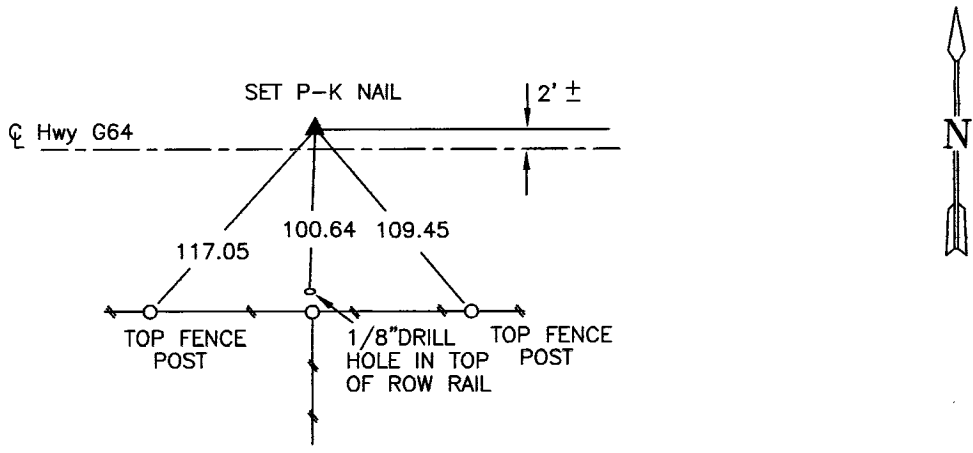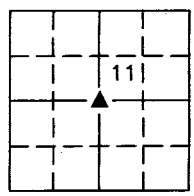

SE CORNER, NW 1/4, SEC. 11

NOTE: ALL TIES TO "X" NAILS UNLESS NOTED.



I hereby certify that the survey work was completed and this certificate was prepared by me or under my direct personal supervision and that I am a duly Licensed Land Surveyor under the laws of the State of Iowa.

Signature: J. Brian Morrissey Date: 3/6/10
J. Brian Morrissey
License number 7995.
My license renewal date is December 31, 2001.