

UNITED STATES PUBLIC LAND SURVEY CORNER CERTIFICATE

OF

Land Survey Monuments situated in Section 30, Township 77 N, Range 27 W, of the Fifth Principal Meridian, Madison County, Iowa. Previously recorded in N.A. in County Recorder's Office.




(book, page, document number, etc.)

(Show reason for preparing this certificate, the evidence and detailed procedures used in establishing the corner positions and monumentation found or placed.)

Monument Description and Remarks: Set 5/8" capped rebar, #7995, at mathematical intersection of center of quarter Section using fence corners at south quarter cor. and center of Section and found east quarter corner and southeast corner of Section

PLAN - VIEW

(Show a minimum of three reference ties to durable physical objects, relevant monuments and physical conditions that will enable recovery of the corner.)

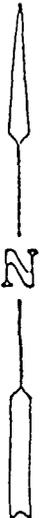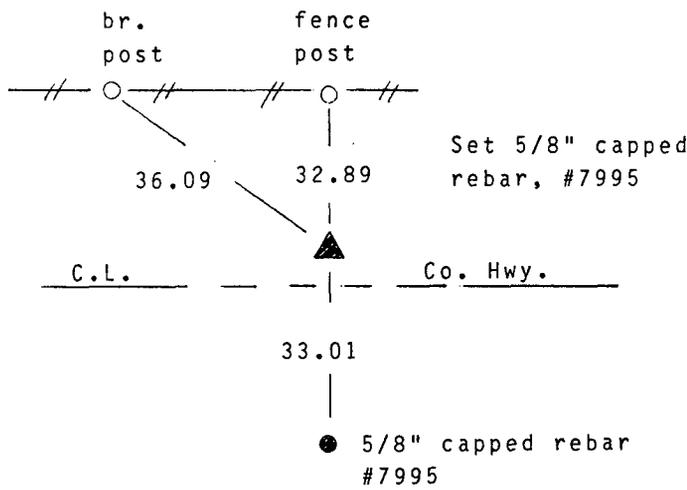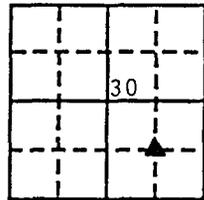

NW. Cor., SE. 1/4, SE. 1/4

Note: all ties to "x" nails unless noted

I hereby certify that the survey work was completed and this certificate was prepared by me or under my direct personal supervision and that I am a duly registered land surveyor under the laws of the state of Iowa. My registration renewal date is 12/31/95.

Signature: J. Brian Morrissey
Name typed or printed: J. Brian Morrissey
Date: Aug. 17, 1995 Reg. No. 7995

Corners	List Corners to be Indexed Section	Twp	Range
NW., SE. 1/4, SE. 1/4	30	77N	27W


REC \$ 5.00
AUDS \$ 1.00
R.M.F. \$ 1.00

FILED NO. 438
BOOK 1 PAGE 304

95 AUG 17 AM 11:08

MICHELLE UTSLER
RECORDER
MADISON COUNTY, IOWA

CONFIRMED
RECORDED
COMPLETED

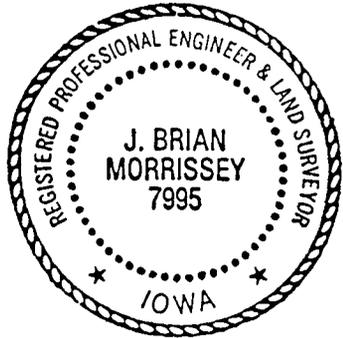

SEAL