SLSI 9-94

UNITED STATES PUBLIC LAND SURVEY CORNER CERTIFICATE

95-1445

OF


Land Survey Monuments situated in Section 1, Township 75 North, Range 26 West, of the Fifth Principal Meridian, Madison County, Iowa.
Previously recorded in N/A in County Recorder's Office.
(book, page, document number, etc.)


(Show reason for preparing this certificate, the evidence and detailed procedures used in establishing the corner positions and monumentation found or placed.)


Monument Description and Remarks: Used reference information from County Engineer's Office and FOUND STONE along fence.

PLAN - VIEW

(Show a minimum of three reference ties to durable physical objects, relevant monuments and physical conditions that will enable recovery of the corner.)

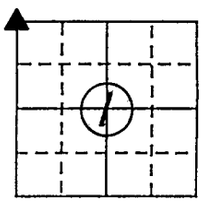

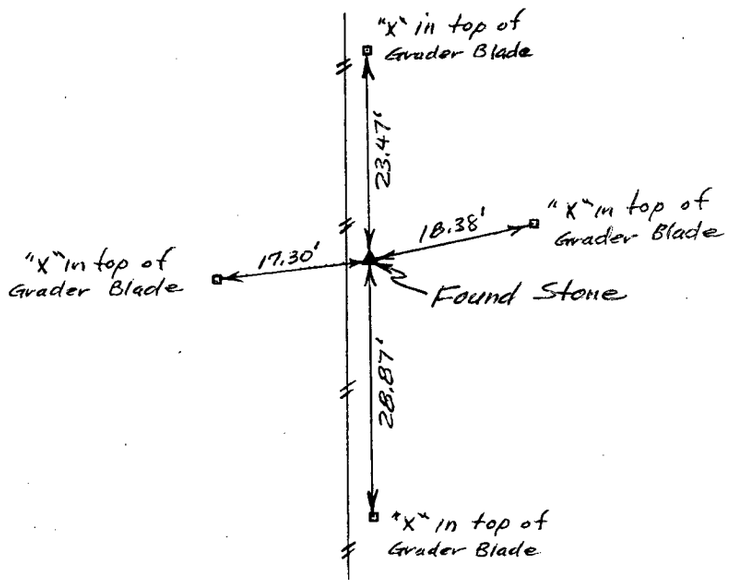

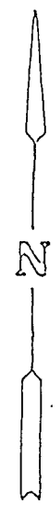

Ref. to NW. Cor., SECTION 1, T75N, R26W

I hereby certify that the survey work was completed and this land surveying document was prepared by me or under my direct personal supervision and that I am a duly registered land surveyor under the laws of the state of Iowa


Signature: Charles T. Vance

Name typed or printed: Charles T. Vance, PE & LS

Date: 9 Oct, 1995 Reg. No. 5041

My registration renewal date is December 31, 1995

SEAL

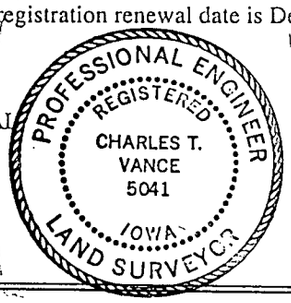

List Corners to be Indexed

Corners	Section	Twp	Range
NW. Cor.	1	75	26

✓
✓
✓

REC $ 5.00
AUD $
R.M.F. $ 1.00

FILED NO. 1041
BOOK 1 PAGE 313
95 OCT 13 PM 3:14
MICHELLE UTSLER
RECORDER
MADISON COUNTY, IOWA