

# UNITED STATES PUBLIC LAND SURVEY CORNER CERTIFICATE

OF

Land Survey Monuments situated in Section 10, Township 75 N, Range 26 W, of the Fifth Principal Meridian, Madison County, Iowa. Previously recorded in N. A. in County Recorder's Office.



(book, page, document number, etc.)

(Show reason for preparing this certificate, the evidence and detailed procedures used in establishing the corner positions and monumentation found or placed.)

Monument Description and Remarks: Set 5/8" capped rebar, #7995 at midpoint between NW. corner and West Quarter of Section 10.

## PLAN - VIEW

(Show a minimum of three reference ties to durable physical objects, relevant monuments and physical conditions that will enable recovery of the corner.)

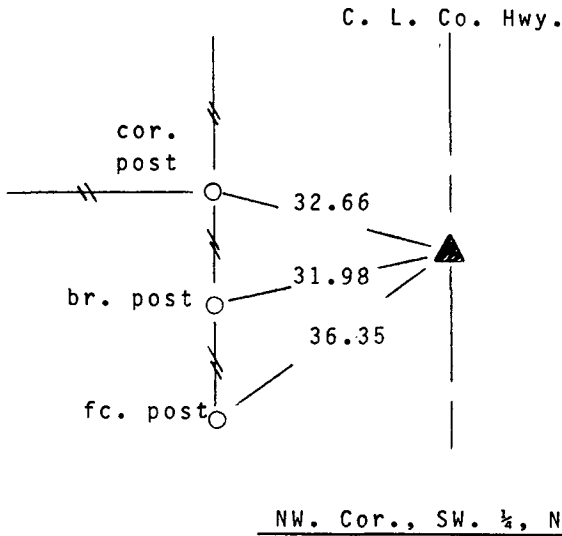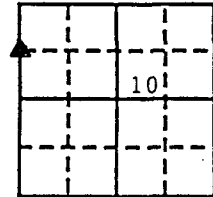

Set 5/8" rebar, cap # 7995



Note: all ties to "x" nails

I hereby certify that the survey work was completed and this certificate was prepared by me or under my direct personal supervision and that I am a duly registered land surveyor under the laws of the state of Iowa. My registration renewal date is 12/31/95.

Signature: J. Brian Morrissey  
Name typed or printed: J. Brian Morrissey

Date: Nov. 6, 1995 Reg. No. 7995

List Corners to be Indexed			
Corners	Section	Twp	Range
NW., SW. 1/4, NW. 1/4	10	75N	26W

REC \$ 5.00  
AUD \$ 1.00  
R.M.F. \$ 1.00

FILED NO. 1298  
BOOK 1 PAGE 314  
95 NOV -6 PM 4: 08

COMPUTER   
RECORDED   
COMPARED

MICHELLE UTSLER  
RECORDER  
MADISON COUNTY, IOWA  
113-95

SEAL

