SLSI 9-90

UNITED STATES PUBLIC LAND SURVEY CORNER CERTIFICATE

OF


Land Survey Monuments situated in Section 12, Township 74 N, Range 26 W, of the Fifth Principal Meridian, Madison County, Iowa.
Previously recorded in N. A. in County Recorder's Office.
(book, page, document number, etc.)


(Show reason for preparing this certificate, the evidence and detailed procedures used in establishing the corner positions and monumentation found or placed.)

Monument Description and Remarks: Found IDOT conc monument set in 1957. Accepted position.

PLAN - VIEW

(Show a minimum of three reference ties to durable physical objects, relevant monuments and physical conditions that will enable recovery of the corner.)

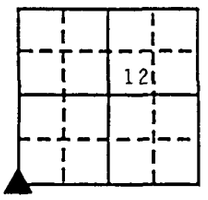

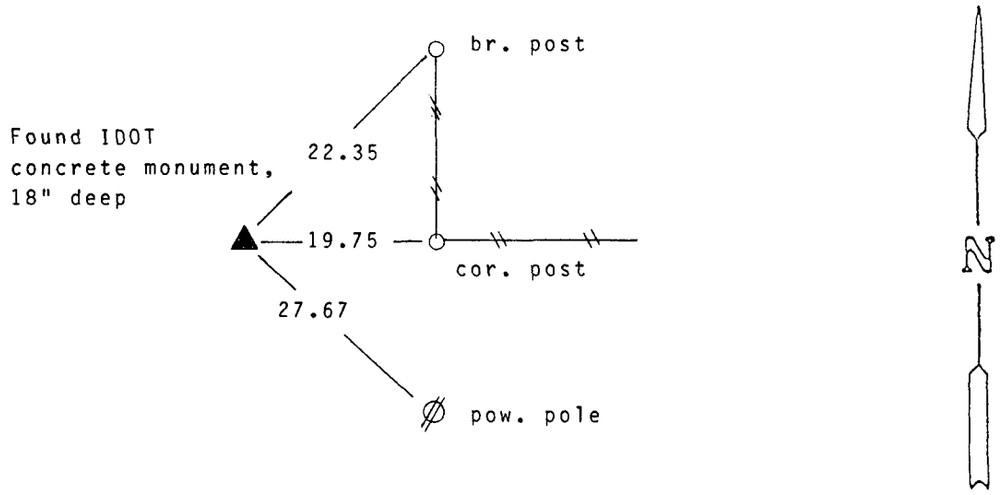

SW. Cor. Sec. 12

Note: all ties to "X" nails unless noted

I hereby certify that the survey work was completed and this certificate was prepared by me or under my direct personal supervision and that I am a duly registered land surveyor under the laws of the state of Iowa. My registration renewal date is 12/31/97.

Signature: J. Brian Morrissey
Name typed or printed: J. Brian Morrissey

Date: Dec. 28, 1995 Reg. No. 7995

SEAL

REGISTERED PROFESSIONAL ENGINEER & LAND SURVEYOR
J. BRIAN MORRISSEY
7995
IOWA

List Corners to be Indexed

Corners	Section	Twp	Range
SW.	12	74N	26W

REC $ 5.00
R.M.F. $ 1.00

FILED NO. 1787
BOOK 1 PAGE 327
95 DEC 29 AM 11: 15

MICHELLE UTSLER
RECORDER
MADISON COUNTY, IOWA

112-95