

REC \$ 500  
A.C.F. \$ 700  
R.M.F. \$ 700

FILED NO. 2001  
BOOK 1 PAGE 341  
96 JAN 22 AM 11:14  
MICHELLE UTSLER  
RECORDER  
MADISON COUNTY, IOWA

COMPUTED   
FIELD   
CONTROL

Prepared By: J. Brian Morrissey, Morrissey Surveying, 1926 Pammel Park Road, Winterset, Ia. 50273, Tele. (515) 462-2166

# UNITED STATES PUBLIC LAND SURVEY CORNER CERTIFICATE OF



Land Survey Monuments situated in Section 16, Township 76 N, Range 27 W, of the Fifth Principal Meridian, Madison County, Iowa.  
Previously recorded in N. A. in County Recorders Office.  
(book, page, document number, etc.)

(Show reason for preparing this certificate, the evidence and detailed procedures used in establishing the corner positions and monumentation found or placed.)

Monument Description and Remarks: Set 5/8" capped rebar, #7995, at midpoint of south quarter corner and SE. cor. of Section. Found 1/2" iron pin used in previous land surveys 28.31' west of set section corner. One-half inch iron pin not accepted.

## PLAN VIEW

(Show a minimum of three reference ties to durable physical objects, relevant monuments and physical conditions that will enable recovery of the corner.)

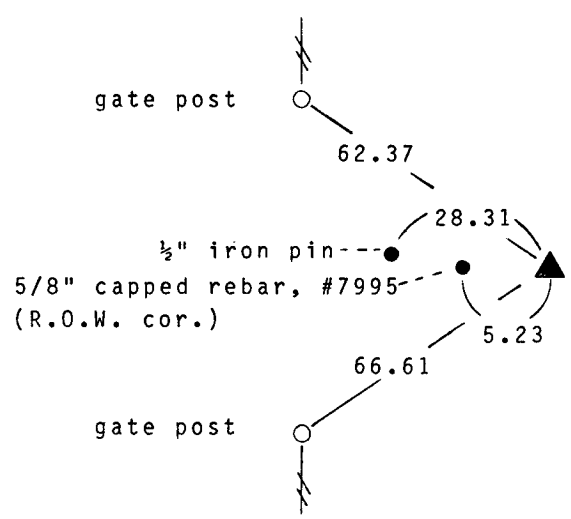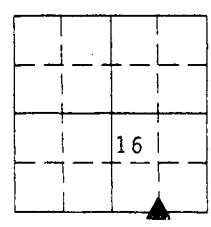

Set 5/8" capped rebar, #7995



SW. Cor., SE. 1/4, SE. 1/4, Sec. 16

Note: all ties to "x" nails unless noted



I hereby certify that the survey work was completed and this certificate was prepared by me or my direct personal supervision and that I am a duly registered land surveyor under the laws of the state of Iowa. My registration renewal date is 12/31/97.

Signature: J. Brian Morrissey

Name typed or printed: J. Brian Morrissey

Date: 1/22/96 Reg.No. 7995