

REC \$ 500  
R.M.F. \$ 700

FILED NO. 2002  
BOOK 1 PAGE 342  
96 JAN 22 AM 11:15  
MICHELLE UTSLER  
RECORDER  
MADISON COUNTY, IOWA

COM. 1 ✓  
F. 2 ✓  
C. 3 ✓

Prepared By: J. Brian Morrissey, Morrissey Surveying, 1926 Pammel Park Road, Winterset, Ia. 50273, Tele. (515) 462-2166

UNITED STATES PUBLIC LAND SURVEY CORNER CERTIFICATE  
OF


Land Survey Monuments situated in Section 16, Township 76 N, Range 27 W, of the Fifth Principal Meridian, Madison County, Iowa.  
Previously recorded in N. A. in County Recorders Office.  
(book,page,document number,etc.)

(Show reason for preparing this certificate, the evidence and detailed procedures used in establishing the corner positions and monumentation found or placed.)


Monument Description and Remarks: Set 5/8" capped rebar, #7995, at fence intersection.  
Position checked reasonably close to distance to S. quarter cor. of Sec. 15-76-27, as  
shown on 11/6/1912 land survey.

PLAN VIEW

(Show a minimum of three reference ties to durable physical objects, relevant monuments and physical conditions that will enable recovery of the corner.)

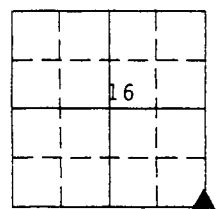

Set 5/8" capped rebar, #7995

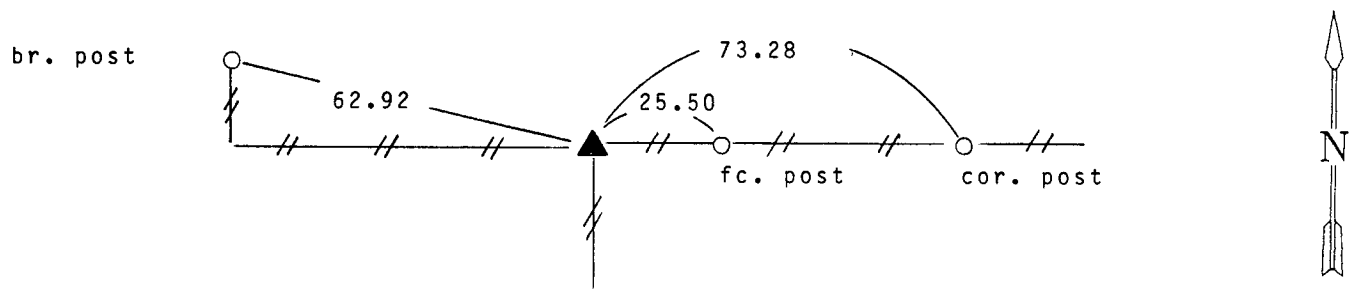

SE. Cor., Sec. 16

Note: all ties to "x" nails



I hereby certify that the survey work was completed and this certificate was prepared by me or my direct personal supervision and that I am a duly registered land surveyor under the laws of the state of Iowa. My registration renewal date is 12/31/97.

Signature: J. Brian Morrissey  
Name typed or printed: J. Brian Morrissey  
Date: 1/22/96 Reg.No. 7995