

95-1945

SLSI 9-94

UNITED STATES PUBLIC LAND SURVEY CORNER CERTIFICATE

OF

Land Survey Monuments situated in Section 26, Township 75 N, Range 29 W, of the Fifth Principal Meridian, MADISON County, Iowa.
Previously recorded in _____ in County Recorder's Office.



(book, page, document number, etc.)

(Show reason for preparing this certificate, the evidence and detailed procedures used in establishing the corner positions and monumentation found or placed.)

Monument Description and Remarks: N.W. Cor. - Set CIR # 6808 based on old road right-of-way fences and property line fences. NE Cor. NW 1/4 NW 1/4 - Set CIR # 6808 based on Road Right-of-way fences and property line fence to the south N 1/4 Cor. - Found 5/8" Rebar from 1987 County Ties.

PLAN - VIEW

(Show a minimum of three reference ties to durable physical objects, relevant monuments and physical conditions that will enable recovery of the corner.)

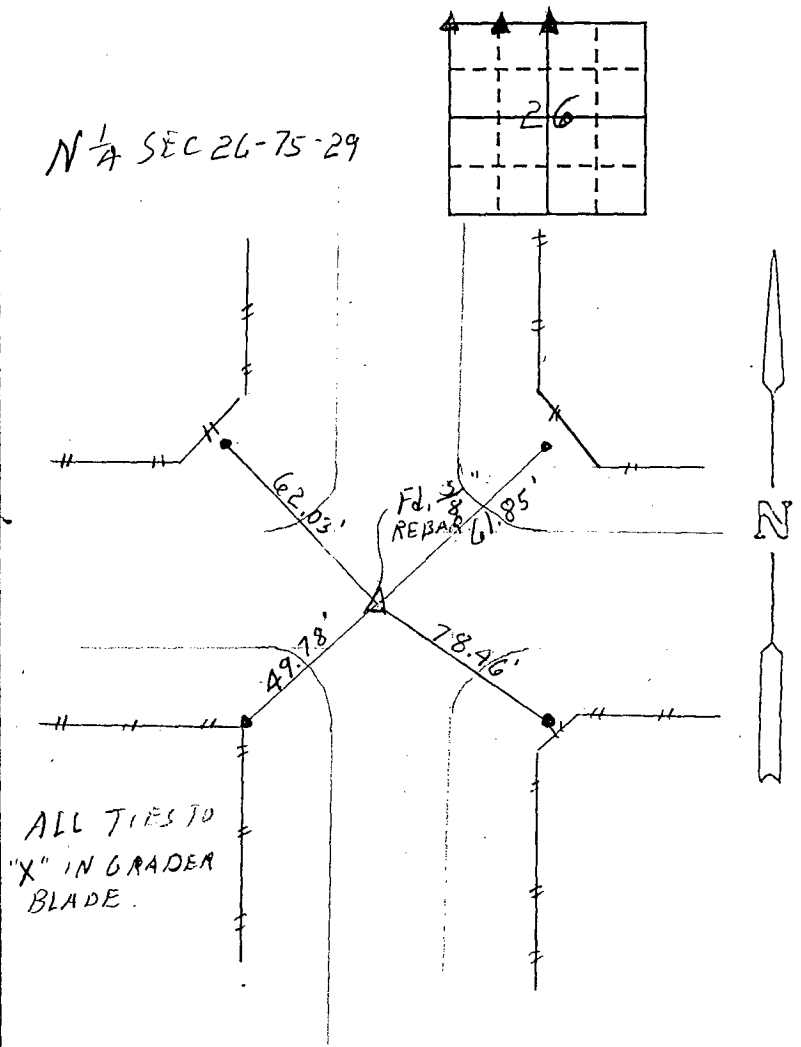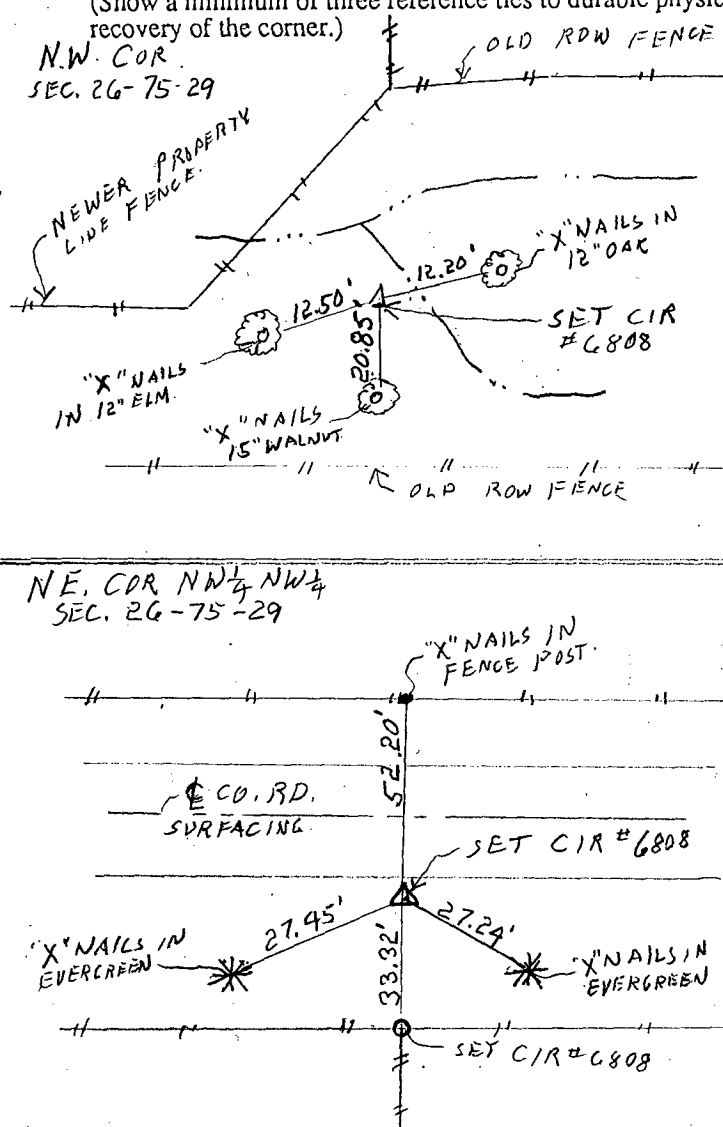

I hereby certify that the survey work was completed and this land surveying document was prepared by me or under my direct personal supervision and that I am a duly registered land surveyor under the laws of the state of Iowa

Signature: J. M. HochstetlerName typed or printed: J. M. HOCHSTETLERDate: 12-29-95 Reg. No. 6808My registration renewal date is December 31, 1997

SEAL



Corners	List Corners to be Indexed		
	Section	Twp	Range
N W COR.	26	75	29
NE COR.	26	75	29
NW 1/4 NW 1/4	26	75	29
N 1/4 Cor	26	75	29

COMPUTER ☒
RECORDED ☒
COMPARED ☒

REC 50
AND 10
R.M.F. 10

FILED NO. **2054**BOOK 1 PAGE 343

96 JAN 30 PM 2:07

MICHELLE UTSLER
RECORDER
MADISON COUNTY, IOWA