

UNITED STATES PUBLIC LAND SURVEY CORNER CERTIFICATE

OF

Land Survey Monuments situated in Section 1, Township 77 NORTH, Range 29 WEST, of the Fifth Principal Meridian, MADISON County, Iowa.
Previously recorded in _____ in County Recorder's Office.

(book, page, document number, etc.)


(Show reason for preparing this certificate, the evidence and detailed procedures used in establishing the corner positions and monumentation found or placed.)

Monument Description and Remarks:


NW Cor. NE $\frac{1}{4}$ NE $\frac{1}{4}$ - Found $\frac{1}{2}$ " I.R. approx. 3" deepSW Cor. SE $\frac{1}{4}$ NE $\frac{1}{4}$ - Found Lead Plug w/P.K. Nail

PLAN - VIEW


(Show a minimum of three reference ties to durable physical objects, relevant monuments and physical conditions that will enable recovery of the corner.)

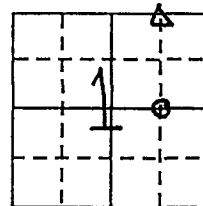

NW CORNER
NE $\frac{1}{4}$ NE $\frac{1}{4}$
SEC. 1-77-29
Fd. $\frac{1}{2}$ " Iron Pin (approx 3" deep)

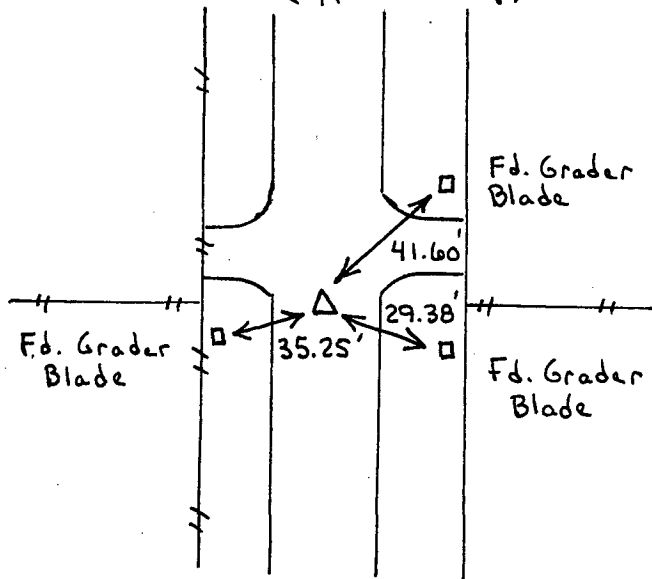

SW CORNER
SE $\frac{1}{4}$ NE $\frac{1}{4}$
SEC. 1-77-29
Fd. Lead Plug w/P.K. Nail

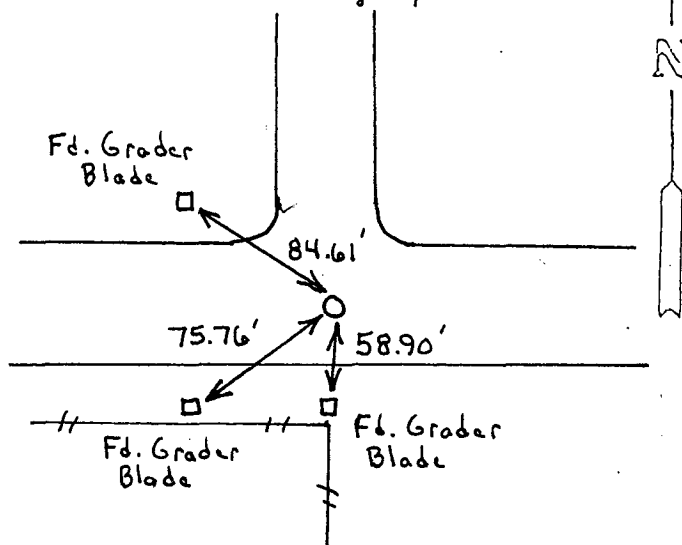

I hereby certify that the survey work was completed and this land surveying document was prepared by me or under my direct personal supervision and that I am a duly registered land surveyor under the laws of the state of Iowa

Signature:

Name typed or printed: J. M. HOCHSTETLER

Date: 11/14/94 Reg. No. 6808

My registration renewal date is December 31, 1997

SEAL



COMPUTER ☒
RECORDED ☒
COMPARED ☒

Corners	List Corners to be Indexed Section	Twp	Range
Δ NW Cor. NE $\frac{1}{4}$ NE $\frac{1}{4}$	1	77N	29W

OSW Cor. SE $\frac{1}{4}$ NE $\frac{1}{4}$	1	77N	29W
---	---	-----	-----

FILED NO. 2055

BOOK 1 PAGE 344

96 JAN 30 PH 2:09

MICHELLE UTSLEIN
RECORDER
MADISON COUNTY, IOWA

REC \$ 5.00

AND \$

R.M.F. \$ 1.00