

UNITED STATES PUBLIC LAND SURVEY CORNER CERTIFICATE

OF

Land Survey Monuments situated in Section 13, Township 77 NORTH, Range 26 WEST, of the Fifth Principal Meridian, MADISON County, Iowa. Previously recorded in _____ in County Recorder's Office.


(book, page, document number, etc.)

(Show reason for preparing this certificate, the evidence and detailed procedures used in establishing the corner positions and monumentation found or placed.)


Monument Description and Remarks: SW CORNER - SET C.I.R. # 6808 BASED ON PINS FROM PRIOR (1981) SURVEY.
W. 1/4 CORNER - Found Capped Iron Pipe # 8169 @ 4-WAY FENCE CORNER.

PLAN - VIEW


(Show a minimum of three reference ties to durable physical objects, relevant monuments and physical conditions that will enable recovery of the corner.)

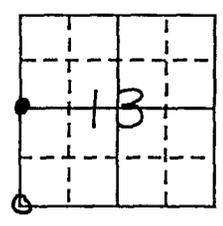

W. 1/4 Corner
Sec. 13-77-26
Fd. C.I.P. # 8169

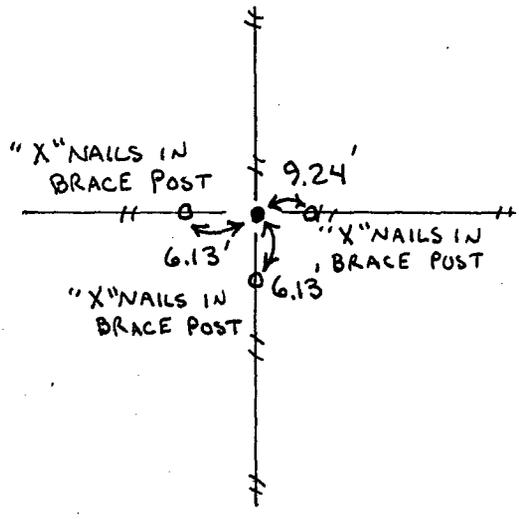

SW Corner
Sec. 13-77-26
Set C.I.R. # 6808

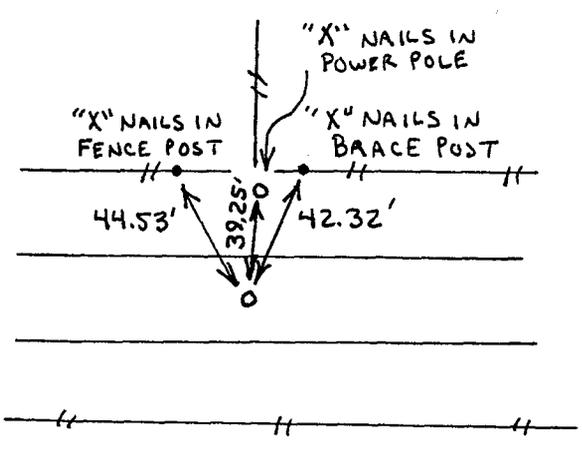

I hereby certify that the survey work was completed and this land surveying document was prepared by me or under my direct personal supervision and that I am a duly registered land surveyor under the laws of the state of Iowa

Signature: J. M. Hochstetler
Name typed or printed: J. M. HOCHSTETLER

Date: 1/16/96 Reg. No. 6808

My registration renewal date is December 31, 1997

Corners	List Corners to be Indexed Section	Twp	Range
● W 1/4 cor.	13	77N	26 W
○ SW cor.	13	77N	26 W

COMPUTER RECORDED COMPARED

FILED NO. 2198
BOOK 1 PAGE 347

REC \$ 5.00
AUD \$ _____
R.M.F. \$ 2.00

96 FEB 14 AM 9:47
MICHELLE UTSLER
RECORDER
MADISON COUNTY, IOWA

SEAL

