Document 2011 878

Book 2011 Page 878 Type 06 043 Pages 1
Date 4/07/2011 Time 9:26 AM
Rec Amt $9.00

INDX ✓
ANNO
SCAN
CHEK

LISA SMITH, COUNTY RECORDER
MADISON COUNTY IOWA

VANCE & HOCHSTETLER, P.C., CONSULTING ENGINEERS, WINTERSET, IOWA (515) 462-3995
CHARLES T. VANCE, 110 West Green St., Winterset, Iowa, 50273
JAMES M HOCHSTETLER, 110 West Green St., Winterset, Iowa 50273

11-335

UNITED STATES PUBLIC LAND SURVEY CORNER CERTIFICATE OF


Land Survey Monuments situated in Section 24, Township 76 N, Range 28 W., of the Fifth Principal Meridian, MADISON County, Iowa.
Previously recorded in _____ (book, page, document number, etc.) in County Recorder's Office.


(Show reason for preparing this certificate, the evidence and detailed procedures used in establishing the the corner positions and monumentation found or placed.)

Monument Description and Remarks: SW COR SE¼ NW¼ - Set yellow CIR #6808 on line between found W¼ Cor and center of Section and in line with the centerline of a County Road North. NW Cor NE¼ NW¼ - Set yellow CIR #6808 at centerline of County Road in line with old property line fence East. Original road dedication indicates that the road is centered on the West line of the E½ of NW¼.

PLAN - VIEW

(Show a minimum of three reference ties to durable physical objects, relevant monuments and physical conditions that will enable recovery of the corner.)

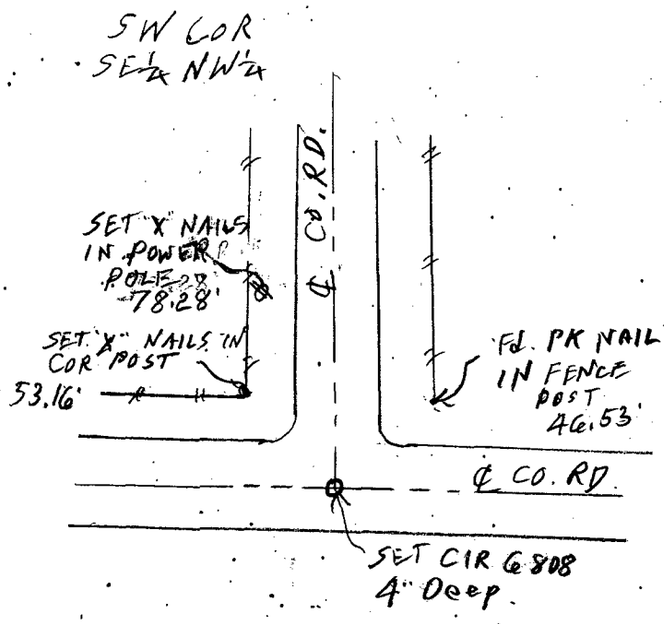

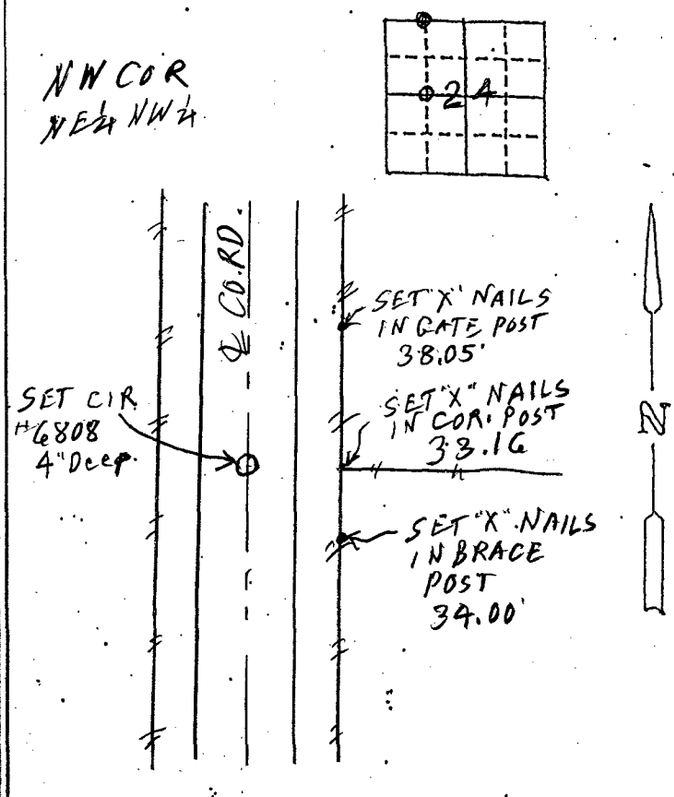

LICENSED LAND SURVEYOR
J. M. HOCHSTETLER
#6808
IOWA

I hereby certify that this land surveying document was prepared and the related survey work was performed by me or under my direct personal supervision and that I am a duly licensed Land Surveyor under the laws of the State of Iowa.

J.M. Hochstetler

J.M. HOCHSTETLER
License number 6808 Date 3/29/11
My license renewal date is December 31, 2011
Pages or sheets covered by this seal: 1

List Corners to be Indexed

Corners	Section	Twp.	Range
SW COR SE¼ NW¼	24	76N	28W
N.W. COR NE¼ NW¼	24	76N	28W