

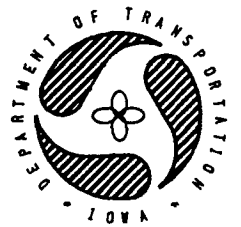


UNITED STATES PUBLIC LAND SURVEY CORNER CERTIFICATE

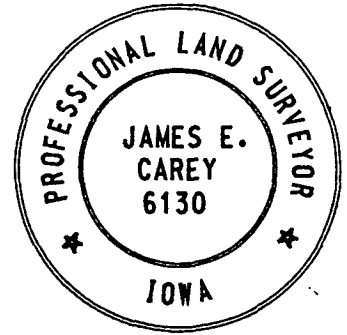




Section 4 Township 75N Range 29W County MADISON

Certificate Prepared For: Culvert Project along Primary Road No. Ia. 92

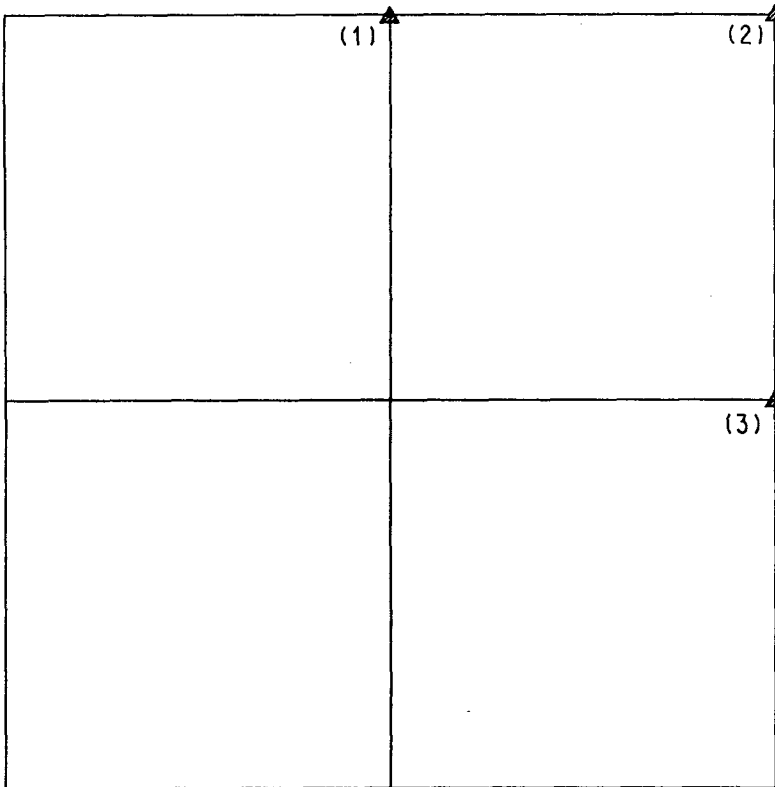

I hereby certify that this plat is a true and accurate representation of the land herein described, made by me or under my direct supervision, and that I am a duly registered Land Surveyor under the laws of the State of Iowa.

James E. Carey 2-8-91
 James E. Carey Reg. No. 6130 Date

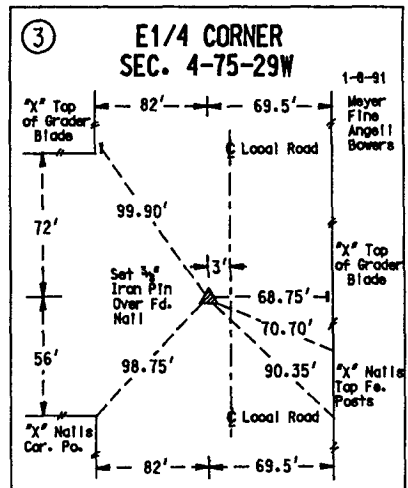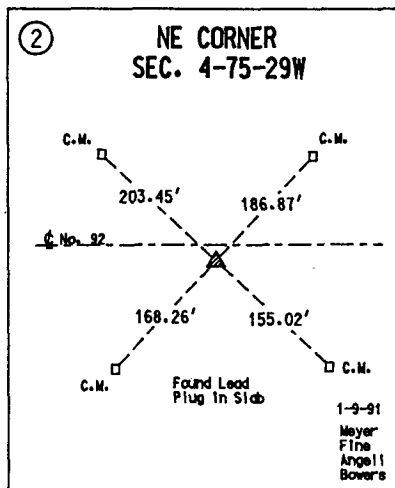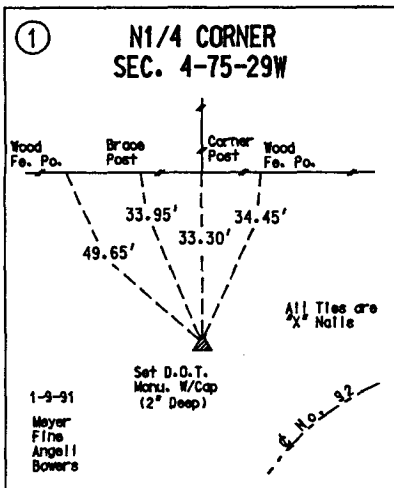

COMPARED

COMPUTED

FILED NO. **1585**
 LAND CORNER SURVEY
 BOOK 1 PAGE 8

IND. ✓
 REC. ✓
 PAGE ✓

91 FEB -8 AM 10:28

MICHELLE UTSLER
 RECORDER
 MADISON COUNTY, IOWA

Fee \$5.00

List Corner to be Indexed

Corners	Section	Twp	Range
N1/4	4	75N	29W
NE	4	75N	29W
E1/4	4	75N	29W